IREDELL COUNTY HEALTH DEPARTMENT

STATESVILLE 704-878-5305 (CA) MOORESVILLE 704-664-5281

IMPROVEMENT PERMIT / AUTHORIZATION TO CONSTRUCT / OPERATION PERMIT / EXISTING SYSTEM INSPECTION

PERMIT# 12070 PIN# 4860656677 DATE 2-20-07

OWNER OR CONTRACTOR Clayton Homes PHONE: Business 704-8732547 Home

ADDRESS 2024 Northside Drive Statesville NC 28677

LOCATION 77N Exit 59 (R) → Tomlex mill RD (L) → Janey Rd (R) → Shearin (L) - end on left

SUBDIVISION Janey Acres BLOCK / SECTION LOT 5 LOT AREA 1.5 SITE CLASS. B DESIGN FLOW 360 L.T.A.R. .25

Septic Tank: 1000 Gallons; STB 1012 Date 9-4-06

Pump Tank: Gallons; PT Date

Pump Make: Model Serial No.

Nitrification Field: No Fields Square Feet 1440 Linear Feet 380

No Lines 7 Trench Width 36 Max Trench Bottom Depth 36 Gravel Depth NA

☐ New System ☐ Repair System Type: I, II, III, IV, V, VI

System Description: 25% Gain

Repair System Description: LPP

Maintenance Agreement Required: ☐ Yes ☑ No Repair

☐ House/Mod. Home No. Bedrooms 3

☑ Mobile Home No. Bathrooms

☐ Business No. Employees

☐ Other


☐ Slab ☑ Crawl Space ☐ Basement w/plumbing ☐ Basement wo/plumbing

Water Supply: ☐ Individual ☑ Public ☐ Community


Comments/Conditions: Install on Contour - Maintain all setbacks - 10' BB property lines

Comments/Conditions: 124W ST marker (1"=40')

INITIAL SITE SKETCH

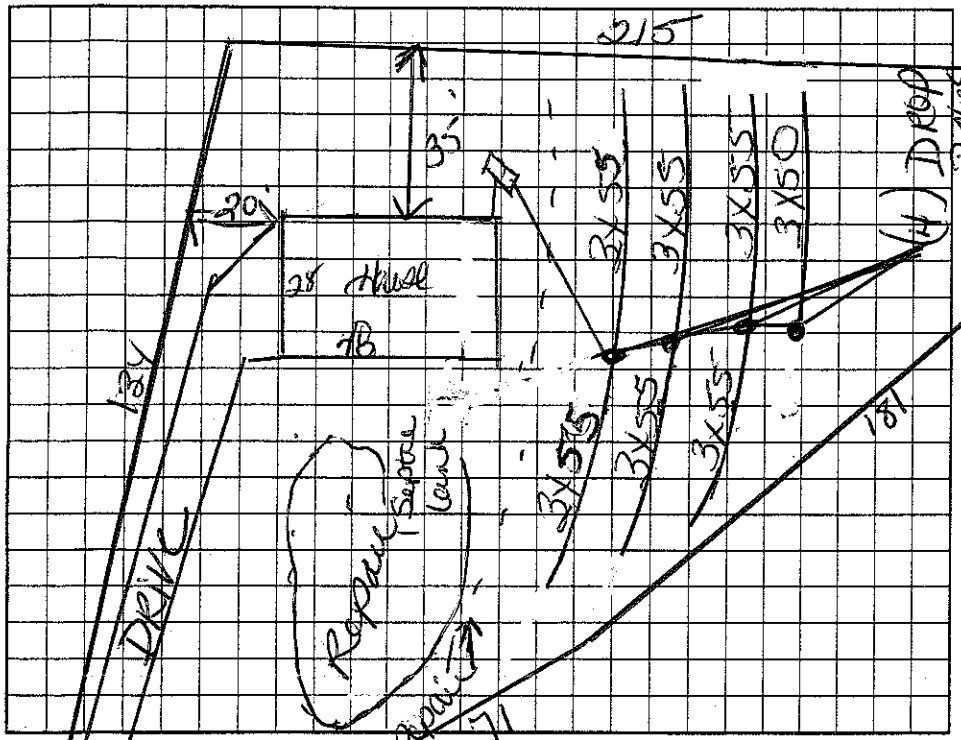

AS BUILT SKETCH

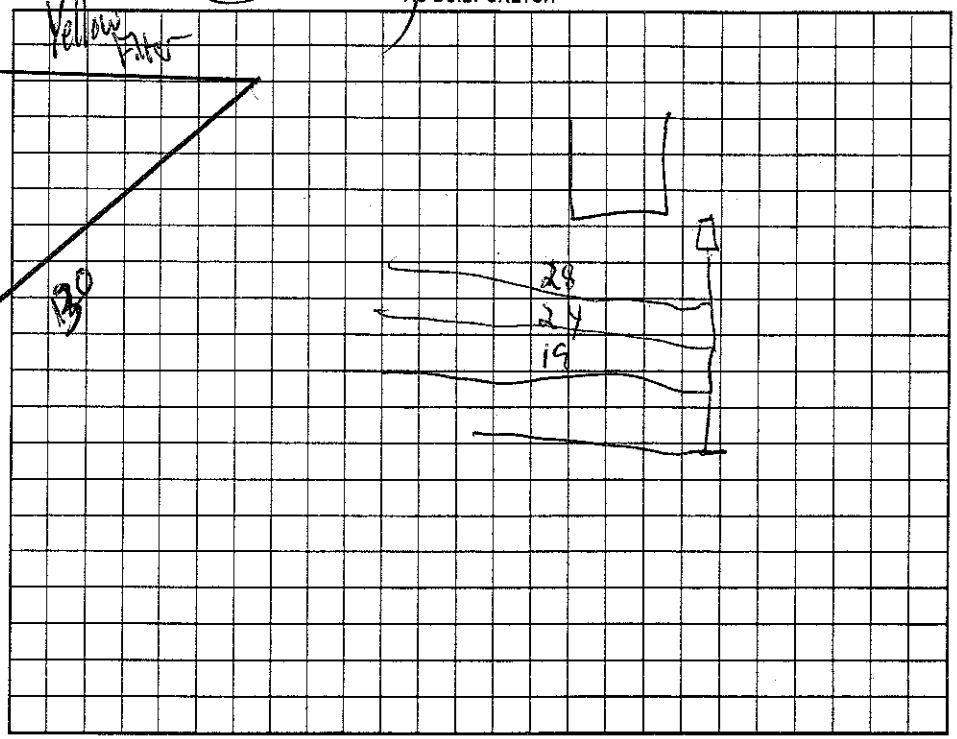

Permit can be suspended or revoked if any false information is supplied toward securing the permit/any unauthorized changes are made to the site/any unauthorized changes are made in the installation of the system. Improvement Permit with plat valid without expiration. Improvement Permit with site plan valid for sixty months. Authorization to Construct is valid for a period equal to that of Improvement Permit – not to exceed sixty months.

Signed: SEARING date Installed by: A-1 Backhoe

Improvement Permit by: date 2-20-07 Operation Permit by: date 3-12-07

Authorization to Construct by: date 2-20-07 Existing System Inspection by: date

HEALTH DEPT. COPY: WHITE OWNER COPY (FINAL): YELLOW OWNER COPY (INITIAL): PINK