IREDELL COUNTY HEALTH DEPARTMENT

STATESVILLE 704-878-5305 MOORESVILLE 704-664-5281

IMPROVEMENT PERMIT / AUTHORIZATION TO CONSTRUCT / OPERATION PERMIT / EXISTING SYSTEM INSPECTION

PERMIT# 093253 PIN# 4860 74 2322 DATE 2-15-00

OWNER OR CONTRACTOR RYAN BUILDERS PHONE: Business 535-4080 Home 450-1434

ADDRESS 310 TOM ROAD, CHARLOTTE NC 28297

LOCATION US 21 N, TL TABOR ROAD, TR FORNEY ROAD, LOT # 23, 4 MIDWAY ON RIGHT

SUBDIVISION FORNEY ACRES BLOCK / SECTION LOT 23 LOT AREA 0.52 ACRES SITE CLASS PS DESIGN FLOW 360 L.T.A.R. 0.30 GPD/FT2

Septic Tank: 1000 Gallons; STB 794 Date 1-29-01
Pump Tank: Gallons; PT Date
Pump Make: Model Serial No.
Nitrification Field: No Fields 1 Square Feet 1200 Linear Feet 400
No Lines FIVE Trench Width 36" Max Trench Bottom Depth 36" Gravel Depth 12"

☑ New System ☐ Repair System Type: I. II. III. IV. V. VI
System Description: CONVENTIONAL SYSTEM
Repair System Description: 25% REDUCTION PUMP
Maintenance Agreement Required: ☐ Yes ☑ No

☐ House/Mod. Home ☑ Mobile Home ☐ Business ☐ Other
No. Bedrooms 3 No. Bathrooms 2 No. Employees


☐ Slab ☑ Crawl Space ☐ Basement w/plumbing ☐ Basement wo/plumbing

Water Supply: ☐ Individual ☑ Public ☐ Community


Comments/Conditions:

Comments/Conditions: SEPTIC TANK WITH MARKER INSTALLED USING "TUFTITE" FILTER

INITIAL SITE SKETCH

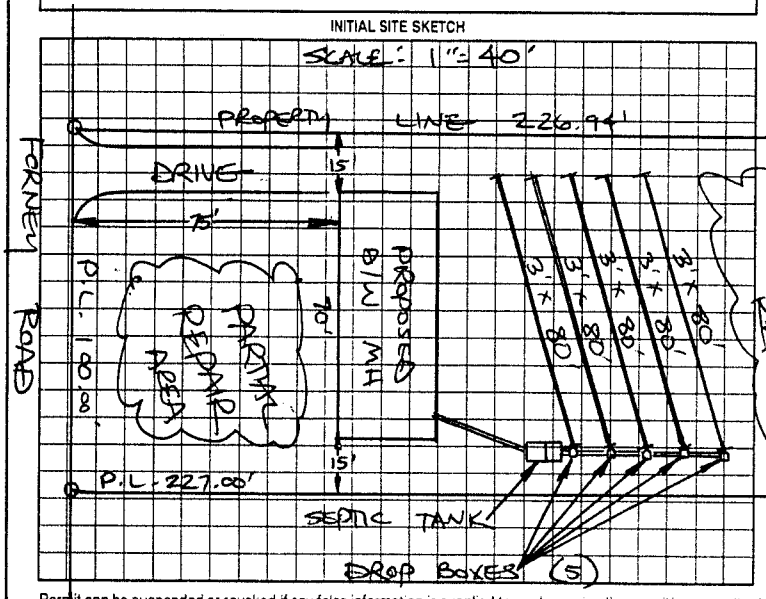

AS BUILT SKETCH

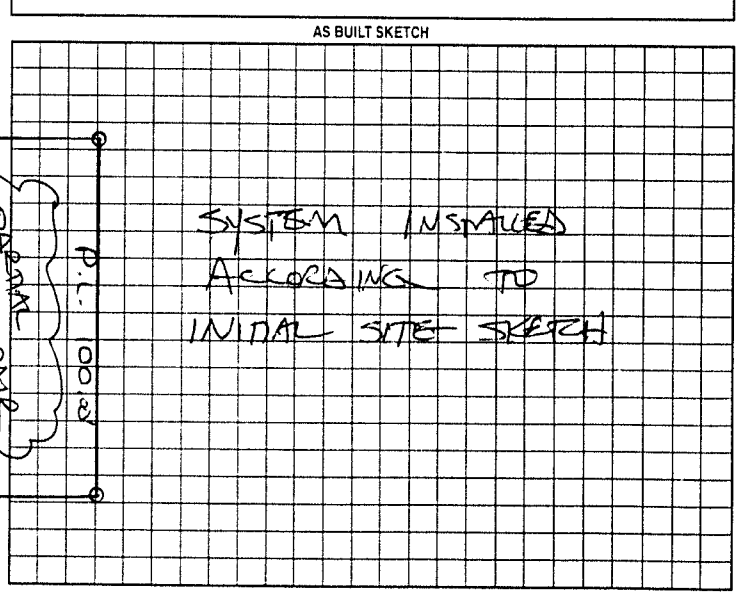

Permit can be suspended or revoked if any false information is supplied toward securing the permit/any unauthorized changes are made to the site/any unauthorized changes are made in the installation of the system. Improvement Permit with plat valid without expiration. Improvement Permit with site plan valid for sixty months. Authorization to Construct is valid for a period equal to that of Improvement Permit – not to exceed sixty months.

Signed: Allen Taylor date 12-15-00

Improvement Permit by: STEVE HEDRICK date 12-15-00

Authorization to Construct by: STEVE HEDRICK date 12-15-00

Installed by: UPRIGHT GRADING

Operation Permit by: STEVE HEDRICK date 1-29-01

Existing System Inspection by: date

HEALTH DEPT COPY: WHITE OWNER COPY (FINAL): YELLOW OWNER COPY (INITIAL): PINK