IREDELL COUNTY HEALTH DEPARTMENT - *ENVIRONMENTAL HEALTH* ☑ STATESVILLE OFFICE 704-878-5305 ☐ MOORESVILLE OFFICE 704-664-5281

IMPROVEMENT PERMIT / AUTHORIZATION TO CONSTRUCT / OPERATION PERMIT / EXISTING SYSTEM INSPECTION

PERMIT # 175027 PIN # 4860-65-7455 DATE SEPTEMBER 21 2012

OWNER MATTHEW GAITHER APPLICANT: SAME PHONE: Home/Cell # 704-539-5089 Business # 704-902-4629

SITE ADDRESS 143 FORNEY DRIVE OWNER / APPLICANT ADDRESS

SITE DIRECTIONS US 21 N TL TABOR ROAD, TR FORNEY DRIVE, 2ND LOT ON (L) PAST SHARON LN

SUBDIVISION FORNEY ACRES BLOCK / SECTION N/A LOT # 8 LOT AREA 10.50 ACRE DESIGN FLOW 360 L.T.A.R. 0.30 GPD/FT2


Septic Tank 1000	Gallons: STB	Date	☐ New System ☐ Repair ☐ Expansion System Type I (II) III IV V VI	☑ Residence	No. Bedrooms 3	Water Supply
Pump Tank	Gallons: P T	Date	System Description: CONVENTIONAL, GRAVITY	☐ Business	No. Persons	☐ Private
Pump Make	Model	Serial #	Repair System Description: CONVENTIONAL, PUMP	☐ Other	No. Employees	☑ Public
No. Nitrification Fields: 1	No. Lines 5'	Linear Feet 400	Maintenance Agreement Required ☐ YES ☑ NO	☐ Slab	☑ Crawl Space	☐ Community
Trench Width 36"	Max. Trench Bottom Depth EX	Gravel Depth 12"	☑ GRAVITY ☐ PRESSURE	☐ Basement w/plumbing	☐ Basement w/o plumbing	

Comments / Conditions

KEEP MH MINIMUM 5' FROM SYSTEM

INITIAL SITE SKETCH

AS BUILT SKETCH

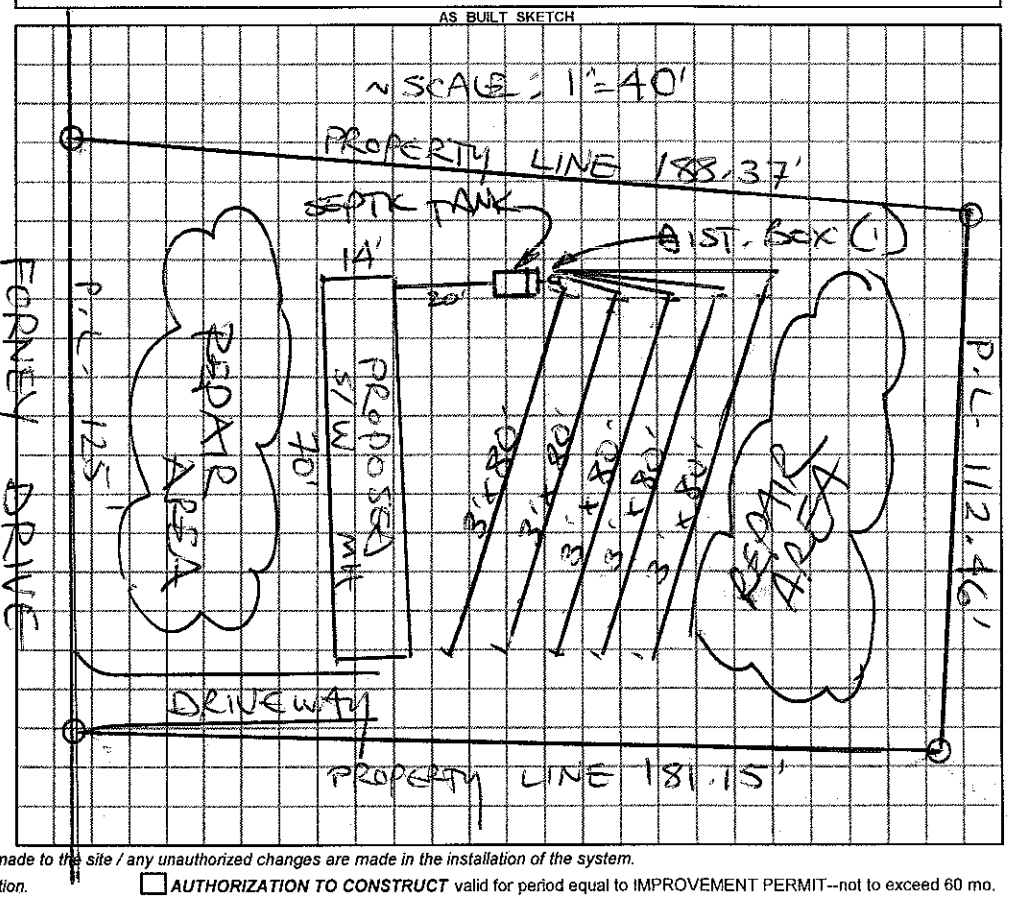

Permit can be suspended or revoked if any false information is supplied toward securing the permit / any unauthorized changes are made to the site / any unauthorized changes are made in the installation of the system.

☐ ***IMPROVEMENT PERMIT*** *with plat valid without expiration.* ☐ ***IMPROVEMENT PERMIT*** *with plat valid without expiration. site plan valid 60 mo.* ☐ ***AUTHORIZATION TO CONSTRUCT*** valid for period equal to IMPROVEMENT PERMIT--not to exceed 60 mo.

Owner / Applicant Signature: _____ Date _____ Installed by: _____

IMPROVEMENT PERMIT by: _____ ***REHS*** Date _____ OPERATION PERMIT by: _____ ***REHS*** Date _____

AUTHORIZATION TO CONSTRUCT by: _____ ***REHS*** Date _____ Existing System Inspected by: STEVE HENRICK ***REHS*** Date 9/21/12

YOU SHOULD CONTACT A LOCATOR SERVICE PRIOR TO ANY EXCAVATION

White Copy – Environmental Health YELLOW COPY (Final) Owner / Applicant PINK COPY (Initial) Owner / Applicant