THIS PERMIT VOIDS PREVIOUS ISSUED 5-22-02

IREDELL COUNTY HEALTH DEPARTMENT

STATESVILLE 704-878-5305 (S1) MOORESVILLE 704-664-5281

IMPROVEMENT PERMIT / AUTHORIZATION TO CONSTRUCT / OPERATION PERMIT / EXISTING SYSTEM INSPECTION

(C1)

PERMIT# 106424 PIN# 4860-65-8575 DATE 5-22-02

OWNER OR CONTRACTOR CYNTHIA SLOVER PHONE: Business Home 704-539-5794

ADDRESS 359 EAGLE MILLS ROAD, HAMPTONVILLE, NC 27020

LOCATION US 21 N, TL TABOR ROAD, TR FORNEY ROAD, 3RD LOT ON LEFT PAST SHEARIN LANE,

SUBDIVISION FORNEY ACRES BLOCK / SECTION LOT 9 LOT AREA 0.96ACRE SITE CLASS PS DESIGN FLOW 360 L.T.A.R. 0.35 GPD/FT²

Septic Tank: 1000 Gallons; STB 1012 Date 4-3-02
Pump Tank: Gallons; PT Date
Pump Make: Model Serial No
Nitrification Field: No Fields 1 Square Feet FROM 1035 Linear Feet 260
No Lines THREE Trench Width 36" Max Trench Bottom Depth 36" Gravel Depth N/A

☑ New System ☐ Repair System Type: I. II. (III) IV. V. VI
System Description: 25% REDUCTION, GRAVITY
Repair System Description: 25% REDUCTION, PUMP
Maintenance Agreement Required: ☐ Yes ☑ No


☐ House/Mod. Home ☑ Mobile Home ☐ Business ☐ Other
No. Bedrooms 3 No. Bathrooms 2 No. Employees
☐ Slab ☑ Crawl Space ☐ Basement w/plumbing ☐ Basement wo/plumbing

Water Supply: ☐ Individual ☑ Public ☐ Community


Comments/Conditions: INSTALL 25% REDUCTION SYSTEM ON CONTOUR AS SHOWN BELOW.

Comments/Conditions: SEPTIC TANK WITH MARKER INSPACED USING "TUFTITE" FILTER

INITIAL SITE SKETCH

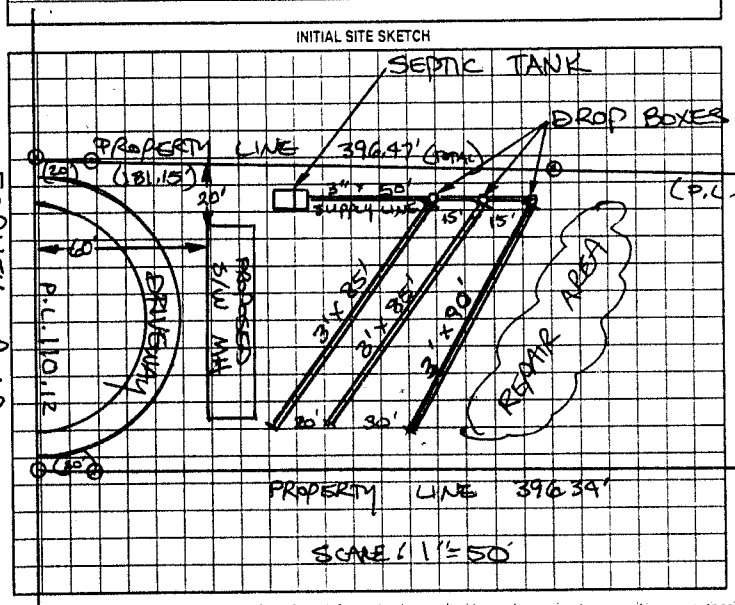

AS BUILT SKETCH

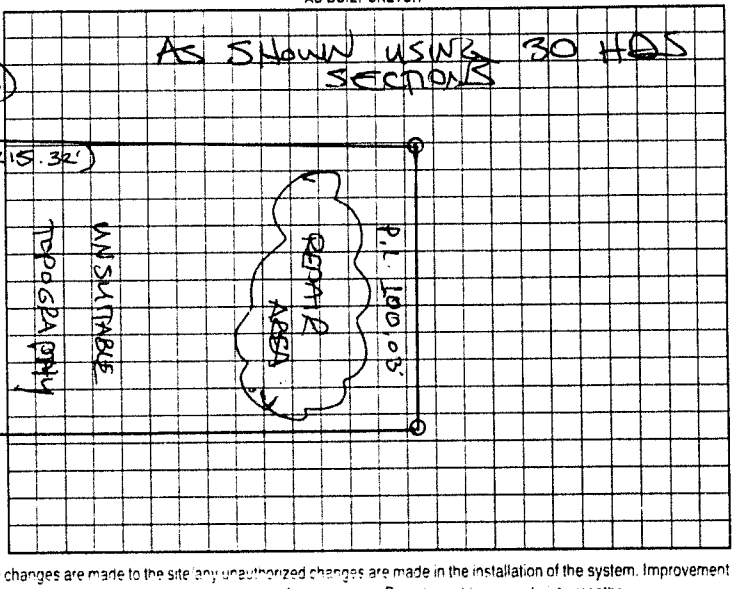

Permit can be suspended or revoked if any false information is supplied toward securing the permit/any unauthorized changes are made to the site/any unauthorized changes are made in the installation of the system. Improvement Permit with plat valid without expiration. Improvement Permit with site plan valid for sixty months. Authorization to Construct is valid for a period equal to that of Improvement Permit - not to exceed sixty months

Signed: Cynthia Slover date 9-20-02 Installed by A-1 BACKHOE

Improvement Permit by: STEVE HEDRICK date 9-19-02 Operation Permit by: STEVE HEDRICK date 10-1-02

Authorization to Construct by: STEVE HEDRICK date 9-19-02 Existing System Inspection by: date

HEALTH DEPT COPY WHITE OWNER COPY (FINAL) YELLOW OWNER COPY (INITIAL) PINK