1-45

IREDELL COUNTY HEALTH DEPARTMENT

STATESVILLE 704-878-5305 (ad) (ad) MOORESVILLE 704-664-5281

IMPROVEMENT PERMIT / AUTHORIZATION TO CONSTRUCT / OPERATION PERMIT / EXISTING SYSTEM INSPECTION

PERMIT # 156358 PIN # 4860659574 DATE 5-14-09

OWNER or APPLICANT Diane Jacobs PHONE: Business Home: 704 223 0268

OWNER or APPLICANT ADDRESS 153 Forney Drive

LOCATION / DIRECTIONS I-77 (R) on Tomlin Mill, Go to end, (L) on Tabor, Forney Dr. is 2-3 mi/lt on (R) 1st on (L)

SUBDIVISION Forney Acres BLOCK / SECTION LOT # 10 LOT AREA .91 DESIGN FLOW 480 L.T.A.R. .3

Septic Tank 1000 Gallons: STB 1017 Date 6-16-09
Pump Tank Gallons: P T Date
Pump Make Model Serial #
Nitrification Field No Fields 1 No Lines 6 Linear Feet 400
Trench Width 36" Max. Trench Bottom Depth 36" Gravel Depth 0/2

☒ New System ☐ Repair ☐ Expansion System Type I (II) III IV V VI
System Description: 25% Reduction Gravity
Repair System Description: 50% Reduction (Pump if nec.)
Maintenance Agreement Required ☐ YES ☒ NO
☒ GRAVITY ☐ PRESSURE

☒ Residence No. Bedrooms 4
☐ Business No. Persons
☐ Other No. Employees
☐ Slab ☒ Crawl Space
☐ Basement w/plumbing ☐ Basement w/o plumbing


Water Supply: ☐ Private ☒ Public ☐ Community

Comments / Conditions


3BR Doublewide okay 3-18-10

Comments / Conditions

INITIAL SITE SKETCH

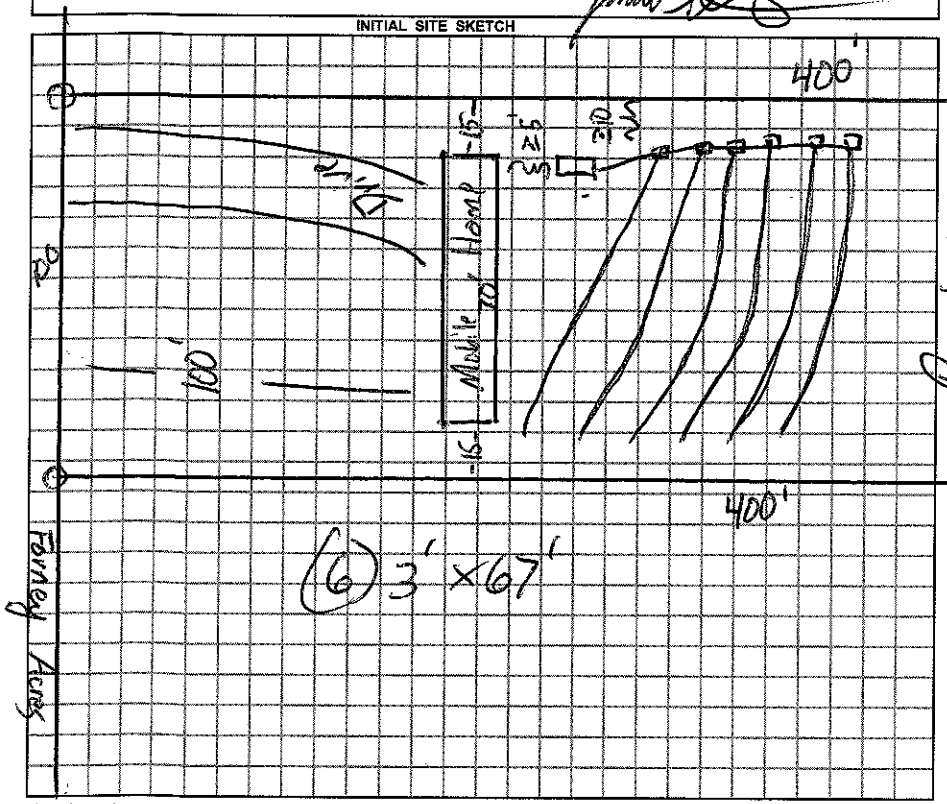

AS BUILT SKETCH

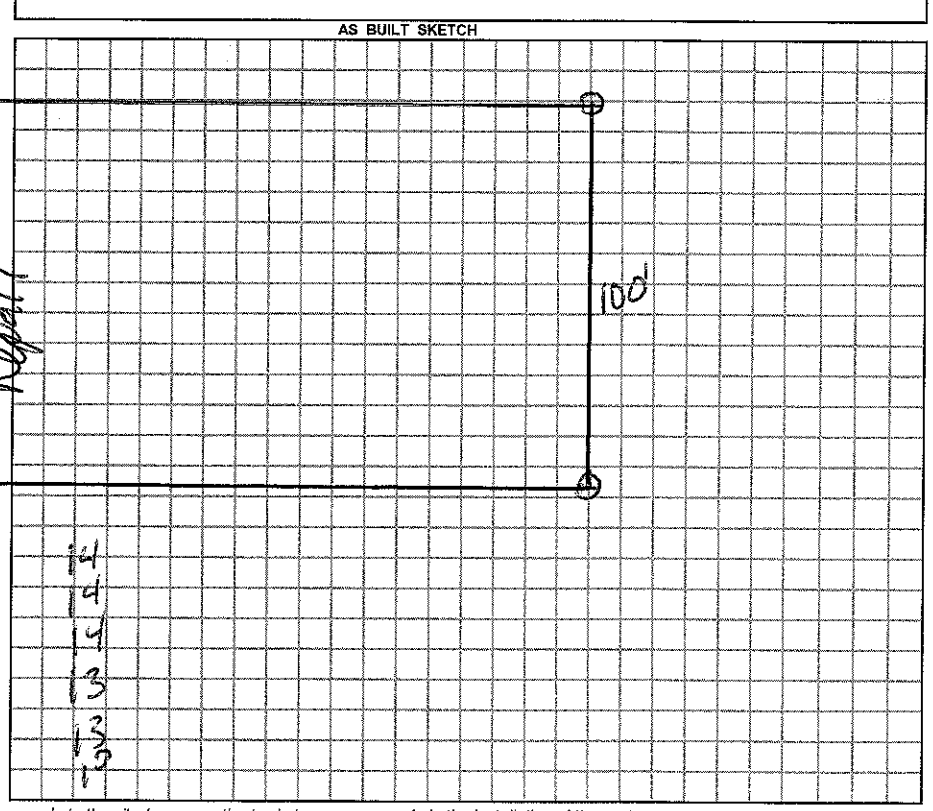

Permit can be suspended or revoked if any false information is supplied toward securing the permit / any unauthorized changes are made to the site / any unauthorized changes are made in the installation of the system.

☐ *IMPROVEMENT PERMIT w / plat valid without expiration.* ☒ *IMPROVEMENT PERMIT w / site plan valid for 60 mos.* ☒ *AUTHORIZATION TO CONSTRUCT valid for period equal to IMPROVEMENT PERMIT-not to exceed 60 mo.*

Owner / Applicant Signature: Diane Jacobs Date 5-14-09

Improvement Permit by: James Date 5-14-09

Authorization to Construct by: James Date 5-14-09

YOU SHOULD CONTACT A LOCATOR SERVICE PRIOR TO ANY EXCAVATION.

Installed by: Groundbreakers

Operation Permit by: James Date: 4-1-10

Existing System Inspected by: Date:

WHITE COPY Environmental Health YELLOW COPY (Final) Owner / Applicant PINK COPY (Initial) Owner / Applicant