IREDELL COUNTY HEALTH DEPARTMENT

STATESVILLE 704-878-5305 MOORESVILLE 704-664-5281

IMPROVEMENT PERMIT / AUTHORIZATION TO CONSTRUCT / OPERATION PERMIT / EXISTING SYSTEM INSPECTION

PERMIT# 140293 PIN# 4860734053 DATE 2-14-07

OWNER OR APPLICANT Anita Gilbert PHONE: Business Home 704-546-7114

ADDRESS 530 Labor Rd 28660

LOCATION 21W (L) Labor Rd (T) Gahon Drive on left

SUBDIVISION BLOCK / SECTION LOT LOT AREA 22.363 SITE CLASS. RS DESIGN FLOW 360 L.T.A.R. .2

Septic Tank: 1000 Gallons; STB 8-25 Date 4-18-07

Pump Tank: Gallons; PT Date

Pump Make: Model Serial No.

Nitrification Field: No Fields Square Feet 1800 Linear Feet 450

No Lines 3 Trench Width 36" Max Trench Bottom Depth 30" Gravel Depth

☑ New System ☐ Repair ☐ Expansion System Type: I II (III) IV V VI

System Description: 25% Conv. w/ pump

Repair System Description: 25% pump

Maintenance Agreement Required: ☐ Yes ☐ No

☑ House/Mod. Home ☐ Mobile Home ☐ Business ☐ Other


No. Bedrooms 3 No. Persons No. Employees

Water Supply: ☑ Individual ☐ Public ☐ Community

☐ Gravity ☐ Pressure ☐ Slab ☐ Crawl Space ☐ Basement w/plumbing ☐ Basement wo/plumbing


Comments:/Conditions: (NOT TO SCALE)

INITIAL SITE SKETCH

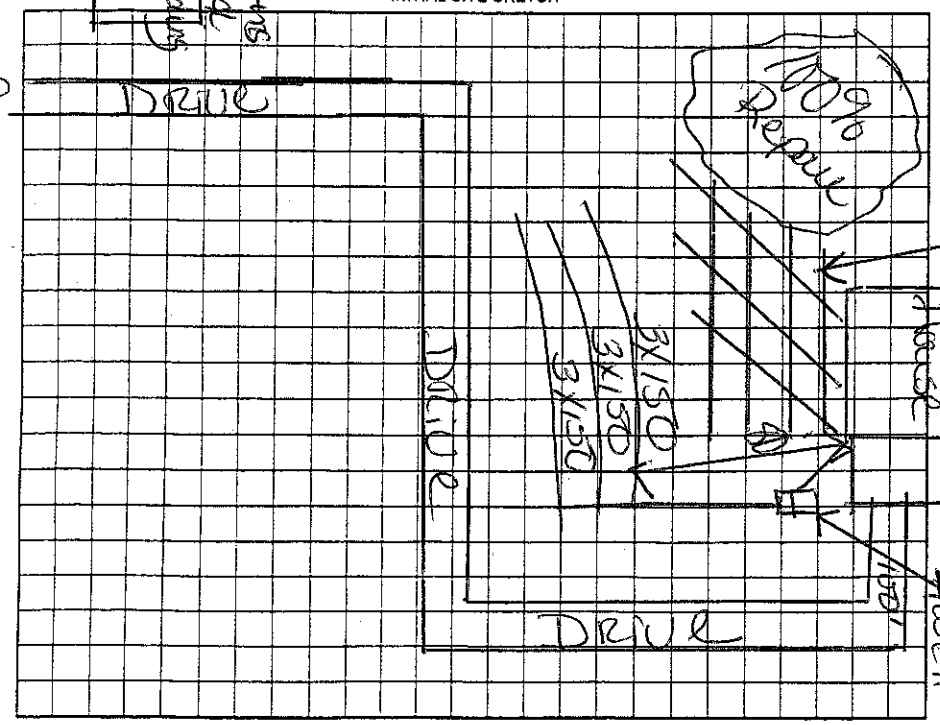

Comments:/Conditions: Install on Contour Maintain all setbacks End cap to ~~cover~~ endcap distribution

AS BUILT SKETCH

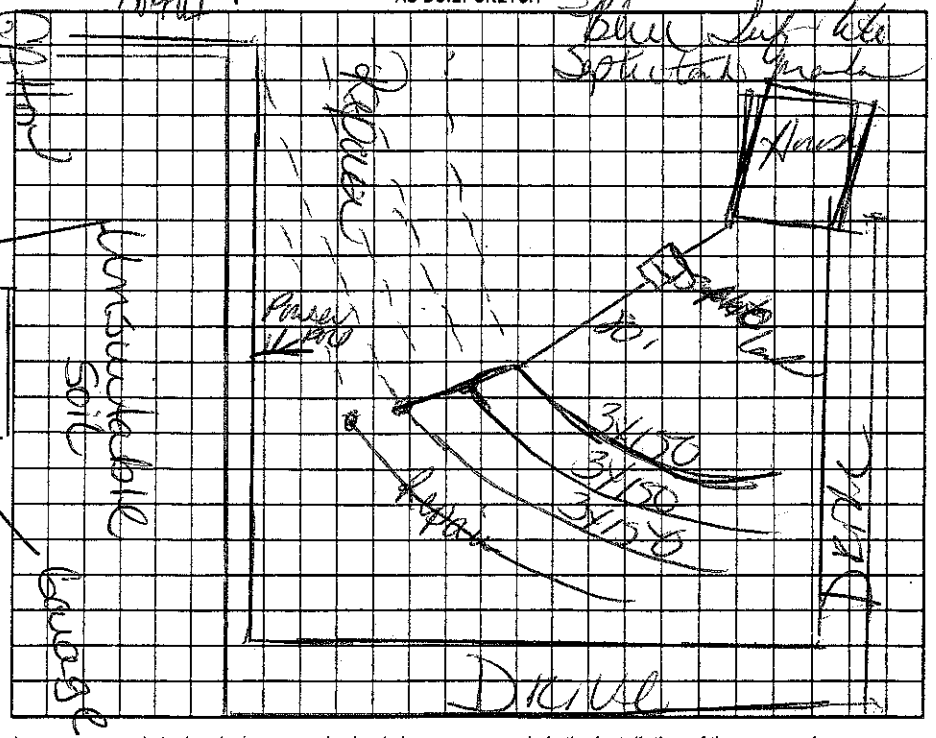

Permit can be suspended or revoked if any false information is supplied toward securing the permit/any unauthorized changes are made to the site/any unauthorized changes are made in the installation of the system. Improvement Permit with plat valid without expiration. ☐ Improvement Permit with site plan valid for sixty months ☐ Authorization to Construct is valid for a period equal to that of Improvement Permit – not to exceed sixty months.

Signed: Anita Gilbert date 2-19-07

Improvement Permit by: Kelly Cook date 2-14-07

Authorization to Construct by: Kelly Cook date 2-14-07

Installed by: NWAA Septic

Operation Permit by: Kelly Cook date 4 June 07

Existing System Inspection by: date

HEALTH DEPT. COPY: WHITE OWNER COPY (FINAL): YELLOW OWNER COPY (INITIAL): PINK