IREDELL COUNTY HEALTH DEPARTMENT

*PERMIT REPLACES EXISTING PERMIT ISSUED 12-18-03, NOW VOID

STATESVILLE 704-878-5305 MOORESVILLE 704-664-5281

IMPROVEMENT PERMIT / AUTHORIZATION TO CONSTRUCT / OPERATION PERMIT / EXISTING SYSTEM INSPECTION

PERMIT# 117066 PIN# 4860-74-0637 DATE 6-28-04

OWNER OR CONTRACTOR A-1 BUILDERS, LLC PHONE: Business (828) 381-2833 Home

ADDRESS PO BOX 6723 STATESVILLE NC 28687

LOCATION I-77 N TR TOMLIN MILL RD TL TABOR RD TR ASHFORD RD LOT #27 ON RIGHT

SUBDIVISION Holly RIDGE BLOCK / SECTION 2 LOT 27 LOT AREA .73 SITE CLASS. PS DESIGN FLOW 360 L.T.A.R. 0.3 gpd/ft²

Septic Tank: 1000 Gallons; STB 1012 Date 3-28-04

Pump Tank: Gallons; PT Date

Pump Make: Model Serial No.

Nitrification Field: No Fields 1 Square Feet 1200 Linear Feet 300

No Lines 4 Trench Width 36" Max Trench Bottom Depth 36" Gravel Depth N/A

☑ New System ☐ Repair System Type: I, II, (III) IV, V, VI

System Description: 25% REDUCTION GRAVITY

Repair System Description: SAME

Maintenance Agreement Required: ☐ Yes ☑ No

☑ House/Mod. Home No. Bedrooms 3

☐ Mobile Home No. Bathrooms 2

☐ Business No. Employees

☐ Other


☐ Slab ☑ Crawl Space ☐ Basement w/plumbing ☐ Basement wo/plumbing

Water Supply: ☐ Individual ☑ Public ☐ Community IREDELL WATER


Comments/Conditions: ① INSTALL LINES ON CONTOUR ② MAINTAIN ALL SETBACKS

Comments/Conditions: ① TUFFTITE FILTER ② INFILTRATOR CHAMBERS ③ 18" RISER

INITIAL SITE SKETCH

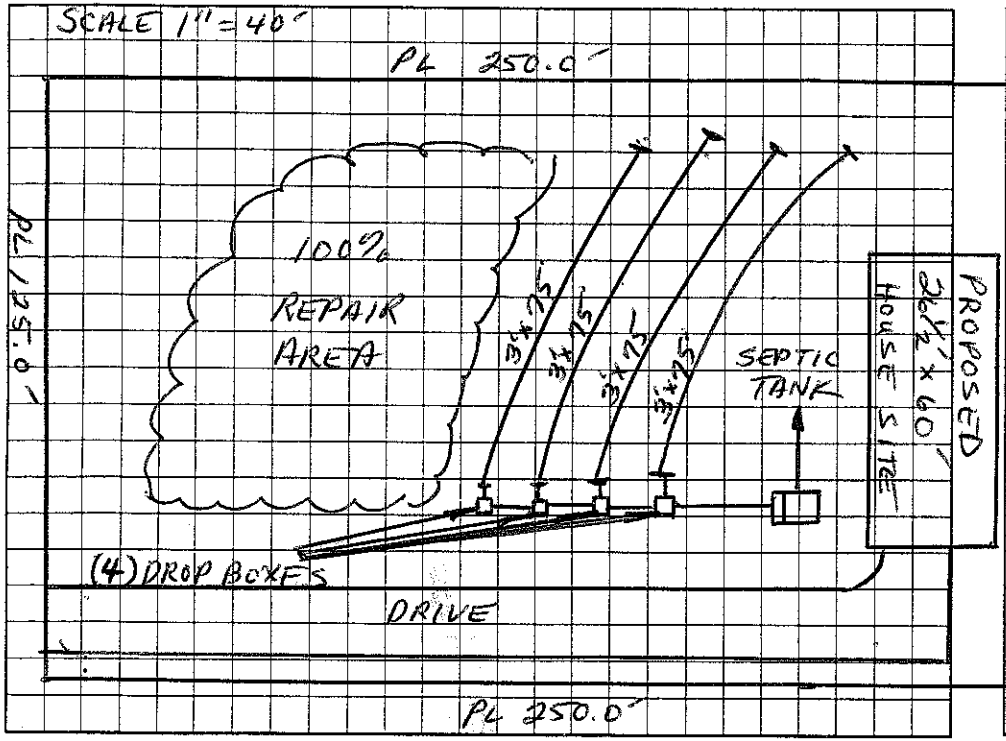

AS BUILT SKETCH

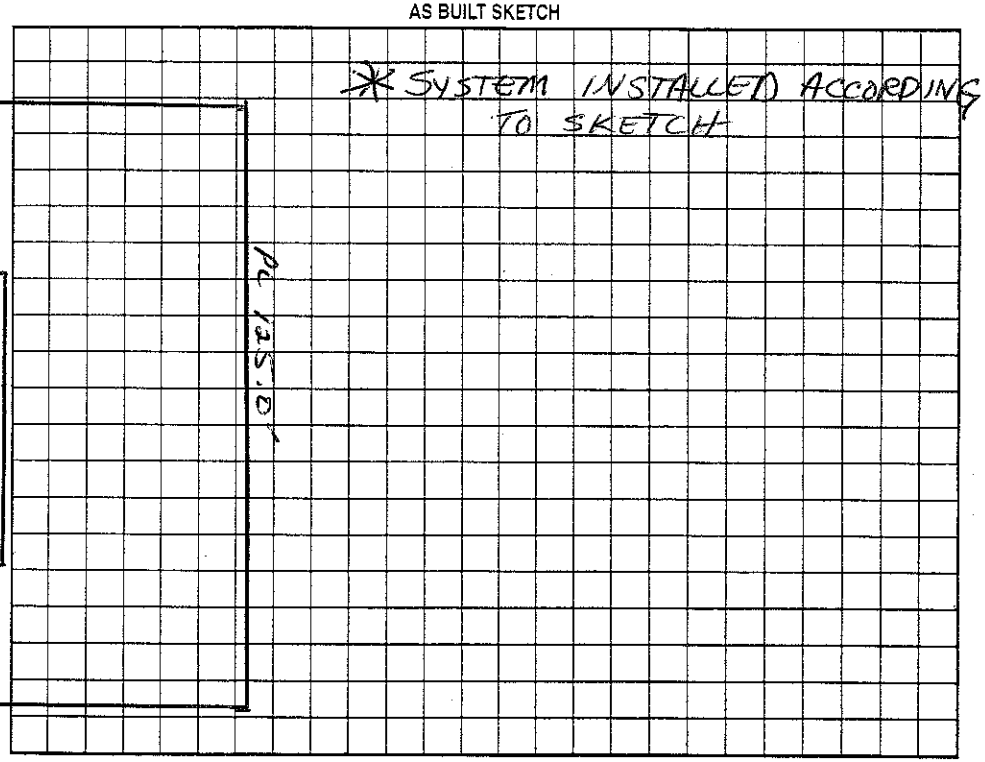

Permit can be suspended or revoked if any false information is supplied toward securing the permit/any unauthorized changes are made to the site/any unauthorized changes are made in the installation of the system. Improvement Permit with plan valid without expiration; Improvement Permit with site plan valid for sixty months. Authorization to Construct is valid for a period equal to that of Improvement Permit – not to exceed sixty months.

Signed: date

Improvement Permit by: Christopher M Steinhilber, RS date 6-28-04

Authorization to Construct by: Christopher M Steinhilber, RS date 6-28-04

Installed by: ESKER ELDER

Operation Permit by: Christopher M Steinhilber, RS date 8-19-04

Existing System Inspection by: date

HEALTH DEPT. COPY: WHITE OWNER COPY (FINAL): YELLOW OWNER COPY (INITIAL): PINK