ICHD - ENVIRONMENTAL HEALTH DIVISION

Statesville Office (704) 878-5305 Mooresville Office (704) 660-3625 PERMIT # AP3160017

SEPTIC: IMPROVEMENT PERMIT / AUTHORIZATION TO CONSTRUCT / OPERATION PERMIT / EXISTING SYSTEM

PIN # 4860 --74 --0945

APPLICANT/OWNER: Jeanne Moulton APPLICANT ADDRESS: PO Box 33306 Charlotte NC 28233

SITE ADDRESS: 149 Ashford Drive Olin NC 28660 PHONE: 980-215-3837 ALT. PHONE 704-885-0488


SITE DIRECTIONS: Tomlin Rd exit 59 on Tabor Rd on Ashford Lot on Left SAP CONTROLLED: ☐ YES ☒ NO

SUBDIVISION: Holly Ridge SECTION: 2 LOT # 8 LOT AREA: .73 Acres DESIGN FLOW: 360 L.T.A.R.: .30

Septic Tank	1000	(gal)	STB 760	Date 2/4/22	☒ New System	☐ Repair	☐ Expansion	System Type: I II (III) IV V VI	☒ Residence	No. Bedrooms 3	Water Supply
Pump Tank		(gal)	PT	Date	System Description: Gravity - 25% Reduction				☐ Business	No. Persons 6	☐ Private
Pump Make		Model		Serial #	Repair System Description: LP-Panel 50% Reduction (.35)				☐ Other	No. Employees	☒ Public
# Nitrification Fields	1	# Lines	5	Linear Ft 300	Maintenance Agreement Required:	☐ YES	☒ NO		☐ Slab	☒ Crawl Space	☐ Community
Trench Width	36in	Trench Bottom Depth(Low side)	36in max	Gravel Depth		☒ GRAVITY	☐ PRESSURE		☐ Basement w/ plumbing		☐ Basement w/o plumbing

Comments / Conditions: ~~X~~ purpose of this permit is ~~to~~ Show new Repair Area due to extreme grading and altering of house placement ~~X~~ Inspection on previous permit issued 5-6-2021

INITIAL SITE SKETCH

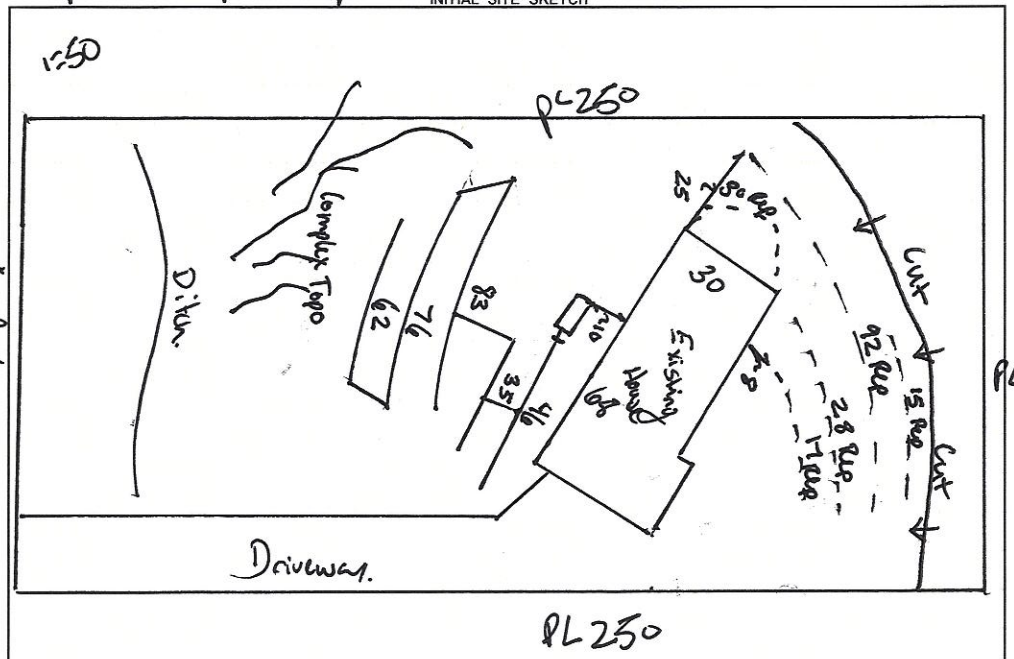

AS BUILT SKETCH

FOR SEPTIC FINAL INSPECTION CALL: 704-664-3703 between 8am-9am the day the inspection is needed. Be sure to speak with an inspector to confirm your time.

Permit can be suspended or revoked if any false information is supplied toward securing the permit / any unauthorized changes are made to the site / any unauthorized changes are made in the installation of the system. **CONTACT A LOCATOR SERVICE PRIOR TO ANY EXCAVATION**

☐ **IMPROVEMENT PERMIT** *with plat valid without expiration.* ☒ **IMPROVEMENT PERMIT** *with site plan valid for 60 mos.* ☒ **AUTHORIZATION TO CONSTRUCT** *valid for period equal to IMPROVEMENT PERMIT--not to exceed 60 mo.*

Owner / Applicant Signature: Jeanne M. Moulton Date: 7/7/22 Installed by: Maiden Grading

IMPROVEMENT PERMIT by: Benjamin A Batts Date: 6-6-2022 OPERATION PERMIT by: Benjamin A Batts Date: 6-6-2022

AUTHORIZATION TO CONSTRUCT by: Benjamin A Batts Date: 6-6-2022 Existing System Inspected by: Date:

FOR SEPTIC FINAL INSPECTION: CALL 704-664-3703 between 8am-9am the day the inspection is needed.

DEPARTMENT OF HEALTH AND HUMAN SERVICES
DIVISION OF PUBLIC HEALTH, ENVIRONMENTAL HEALTH SECTION
ON-SITE WATER PROTECTION BRANCH

Sheet 1 of 1

SOIL/SITE EVALUATION
for ON-SITE WASTEWATER SYSTEM
(Complete all fields in full)

WATER SUPPLY: ☐ Private ☐ Public ☐ Well ☐ Spring ☐ Other
EVALUATION METHOD: ☐ Auger Boring ☐ Pit ☐ Cut
PROPOSED DESIGN FLOW (.1949): 360 gpd
APPLICATION DATE 4/2021
DATE EVALUATED: 4/2021
PROPERTY SIZE: ~73 Acres
PROPERTY RECORDED: yes
TYPE OF WASTEWATER: ☐ Sewage ☐ Industrial Process ☐ Mixed

PROFILE #	.1940 LANDSCAPE POSITION/ SLOPE %	HORIZON DEPTH (IN.)	SOIL MORPHOLOGY (.1941) .1941 STRUCTURE/ TEXTURE	SOIL MORPHOLOGY (.1941) .1941 CONSISTENCE/ MINERALOGY	OTHER PROFILE FACTORS .1942 SOIL WETNESS/ COLOR	OTHER PROFILE FACTORS .1943 SOIL DEPTH	OTHER PROFILE FACTORS .1956 SAPRO CLASS	OTHER PROFILE FACTORS .1944 RESTR HORIZ	PROFILE CLASS & LTAR
1	Side 8-10%	0-24	C SBK	SSSp FR SExP	2.5YR 4/6	48		Some Mn conc. 25-27 Inch	PS .30
		24-48	CL wSBK	SSSp FR					
2	Side 4%	0-6	SCL	SSSp FR SExP	2.5YR 4/6	50		NA	PS .30
		6-32	C SBK	SSSp FR					
		32-50	CL wSBK	SSSp FR					
3	Side 6%	0-6	SCL SBK/GR	SSSp FR SExP	2.5YR 4/6	56		NA	PS .30
		6-32	C SBK	SSSp FR					
		32-56	CL wSBK	SSSp FR					
4	Ridge	0-26	C SBK	SSSp FR SExP	2.5YR 4/6	48		NA	PS .30
		26-48	CL wSBK	SSSp FR SExP					

DESCRIPTION	INITIAL SYSTEM	REPAIR SYSTEM
Available Space (.1945)	300	200
System Type(s)	III	IV
Site LTAR	.30	.30

OTHER FACTORS (.1946):
SITE CLASSIFICATION (.1948):
EVALUATED BY:
OTHER(S) PRESENT: Brittani.

COMMENTS:

LEGEND

use the following standard abbreviations

LANDSCAPE POSITION	GROUP	SOIL TEXTURE	CONVENTIONAL .1955 LTAR*	LPP .1957 LTAR*	MINERALOGY/ CONSISTENCE	STRUCTURE
CC (Concave Slope) CV (Convex Slope) D (Drainage Way) DS (Debris Slump) FP (Flood Plain) FS (Foot Slope) H (Head Slope) L (Linear Slope) N (Nose Slope) R (Ridge) S (Shoulder Slope) T (Terrace)	I	S (Sand) LS (Loamy Sand)	1.2 - 0.8	0.6 - 0.4	SEXP (Slightly Expansive) EXP (Expansive)	G (Single Grain) M (Massive) CR (Crumb) GR (Granular) SBK (Subangular Blocky) ABK (Angular Blocky) PL (Platy) PR (Prismatic)
	II	SL (Sandy Loam) L (Loam)	0.8 - 0.6	0.4 - 0.3		
	III	Si (Silt) SiCL (Silty Clay Loam) CL (Clay Loam) SCL (Sandy Clay Loam) SiL (Silt Loam)	0.6 - 0.3	0.3 - 0.15		
	IV	SC (Sandy Clay) SiC (Silty Clay) C (Clay) O (Organic)	0.4 - 0.1 None	0.2 - 0.05 None		

MOIST	WET
VFR (Very Friable)	NS (Non-sticky)
FR (Friable)	SS (Slightly Sticky)
FI (Firm)	S (Sticky)
VFI (Very Firm v. Very Sticky)	VS (Very Sticky)
EFI (Extremely Firm)	NP (Non-plastic)
	SP (Slightly Plastic)
	P (Plastic)
	VP (Very Plastic)

*Adjust LTAR due to depth, consistence, structure, soil wetness, landscape, position, wastewater flow and quality.


NOTES

HORIZON DEPTH	In inches below natural soil surface
DEPTH OF FILL	In inches from land surface
RESTRICTIVE HORIZON	Thickness and depth from land surface
SAPROLITE	S(suitable) or U(unsuitable)
SOIL WETNESS	Inches from land surface to free water or inches from land surface to soil colors with chroma 2 or less - record Munsell color chip designation
CLASSIFICATION	S (Suitable), PS (Provisionally Suitable), or U (Unsuitable)

Evaluation of saprolite shall be by pits.

Long-term Acceptance Rate (LTAR): gal/day/ft^2

Show profile locations and other site features (dimensions, reference or benchmark, and North).

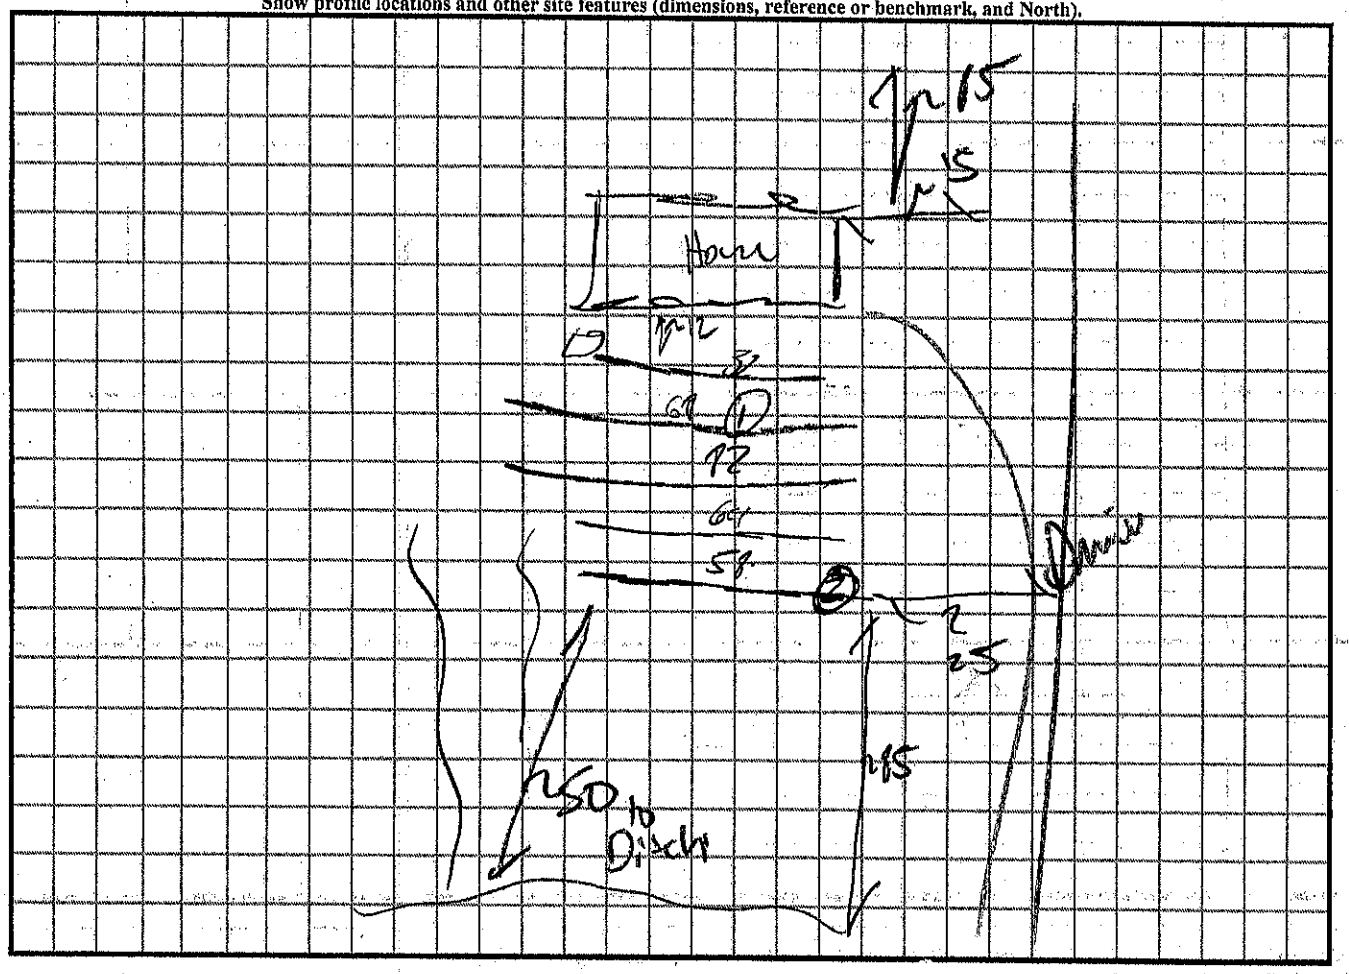

DEPARTMENT OF HEALTH AND HUMAN SERVICES
DIVISION OF PUBLIC HEALTH, ENVIRONMENTAL HEALTH SECTION
ON-SITE WATER PROTECTION BRANCH

Sheet 1 of 1
PROPERTY ID #: 4966749940
COUNTY: Iredell

SOIL/SITE EVALUATION
for ON-SITE WASTEWATER SYSTEM
(Complete all fields in full)

OWNER: Jeanne Moulton
ADDRESS: PO Box 33306 Charlotte NC 28233
PROPOSED FACILITY: SFR
PROPOSED DESIGN FLOW (.1949): 360.
LOCATION OF SITE: 149 Ashford Drive
APPLICATION DATE: 4-1-2022
DATE EVALUATED: 5-31-22
PROPERTY SIZE: .73
PROPERTY RECORDED: Yes

WATER SUPPLY: ☑ Private ☐ Public ☐ Well ☐ Spring ☐ Other
EVALUATION METHOD: ☐ Auger Boring ☑ Pit ☐ Cut
TYPE OF WASTEWATER: ☐ Sewage ☐ Industrial Process ☐ Mixed

PROFILE #	1940 LANDSCAPE POSITION/ SLOPE %	HORIZON DEPTH (IN.)	SOIL MORPHOLOGY (.1941) ,1941 STRUCTURE/ TEXTURE	SOIL MORPHOLOGY (.1941) ,1941 CONSISTENCE/ MINERALOGY	OTHER PROFILE FACTORS .1942 SOIL WETNESS/ COLOR	.1943 SOIL DEPTH	.1956 SAPRO CLASS	.1944 RESTR HORIZ	PROFILE CLASS & LTAR
1	Side 0-1%	0-10	Fill	—	PS		PS	NA	PS .35 Many Gravel Inclusions Mica Inclusions
		10-55	L Sap M	NS Np VFR					
2	Side 1-1%	0-14	C SBK - Common		PS	14	~~PS~~ NA	NA	PS .30 Heavy SAP Increasing
		14-56	CL SBK	SS SP FR SBK					
3									
4									

DESCRIPTION	INITIAL SYSTEM	REPAIR SYSTEM
Available Space (.1945)		200 L.F.
System Type(s)		IV 4-50"
Site LTAR		.30

OTHER FACTORS (.1946):
SITE CLASSIFICATION (.1948):
EVALUATED BY:
OTHER(S) PRESENT:

COMMENTS: ~~System already installed~~ - Repair Area destroyed/graded away

Updated February 2014

LEGEND

use the following standard abbreviations

LANDSCAPE POSITION	GROUP	SOIL TEXTURE	CONVENTIONAL .1955 LTAR*	LPP .1957 LTAR*	MINERALOGY/ CONSISTENCE	STRUCTURE
CC (Concave Slope)	I	S (Sand)	1.2 - 0.8	0.6 - 0.4	SEXP (Slightly Expansive)	G (Single Grain)
CV (Convex Slope)		LS (Loamy Sand)			EXP (Expansive)	M (Massive)
D (Drainage Way)						CR (Crumb)
DS (Debris Slump)	II	SL (Sandy Loam)	0.8 - 0.6	0.4 - 0.3		GR (Granular)
FP (Flood Plain)		L (Loam)				SBK (Subangular Blocky)
FS (Foot Slope)						ABK (Angular Blocky)
H (Head Slope)	III	Si (Silt)	0.6 - 0.3	0.3 - 0.15		PL (Platy)
L (Linear Slope)		SiCL (Silty Clay Loam)				PR (Prismatic)
N (Nose Slope)		CL (Clay Loam)				
R (Ridge)		SCL (Sandy Clay Loam)			**MOIST**	**WET**
S (Shoulder Slope)		SiL (Silt Loam)				
T (Terrace)					VFR (Very Friable)	NS (Non-sticky)
	IV	SC (Sandy Clay)	0.4 - 0.1	0.2 - 0.05	FR (Friable)	SS (Slightly Sticky)
		SiC (Silty Clay)			FI (Firm)	S (Sticky)
		C (Clay)			VFI (Very Firm v. Very Sticky)	VS (Very Sticky)
		O (Organic)	None	None	EFI (Extremely Firm)	NP (Non-plastic)
						SP (Slightly Plastic)
						P (Plastic)
						VP (Very Plastic)

*Adjust LTAR due to depth, consistence, structure, soil wetness, landscape, position, wastewater flow and quality.


NOTES


HORIZON DEPTH	In inches below natural soil surface
DEPTH OF FILL	In inches from land surface
RESTRICTIVE HORIZON	Thickness and depth from land surface
SAPROLITE	S(suitable) or U(unsuitable)
SOIL WETNESS	Inches from land surface to free water or inches from land surface to soil colors with chroma 2 or less - record Munsell color chip designation
CLASSIFICATION	S (Suitable), PS (Provisionally Suitable), or U (Unsuitable)

Evaluation of saprolite shall be by pits.

Long-term Acceptance Rate (LTAR): gal/day/ft^2

Show profile locations and other site features (dimensions, reference or benchmark, and North).

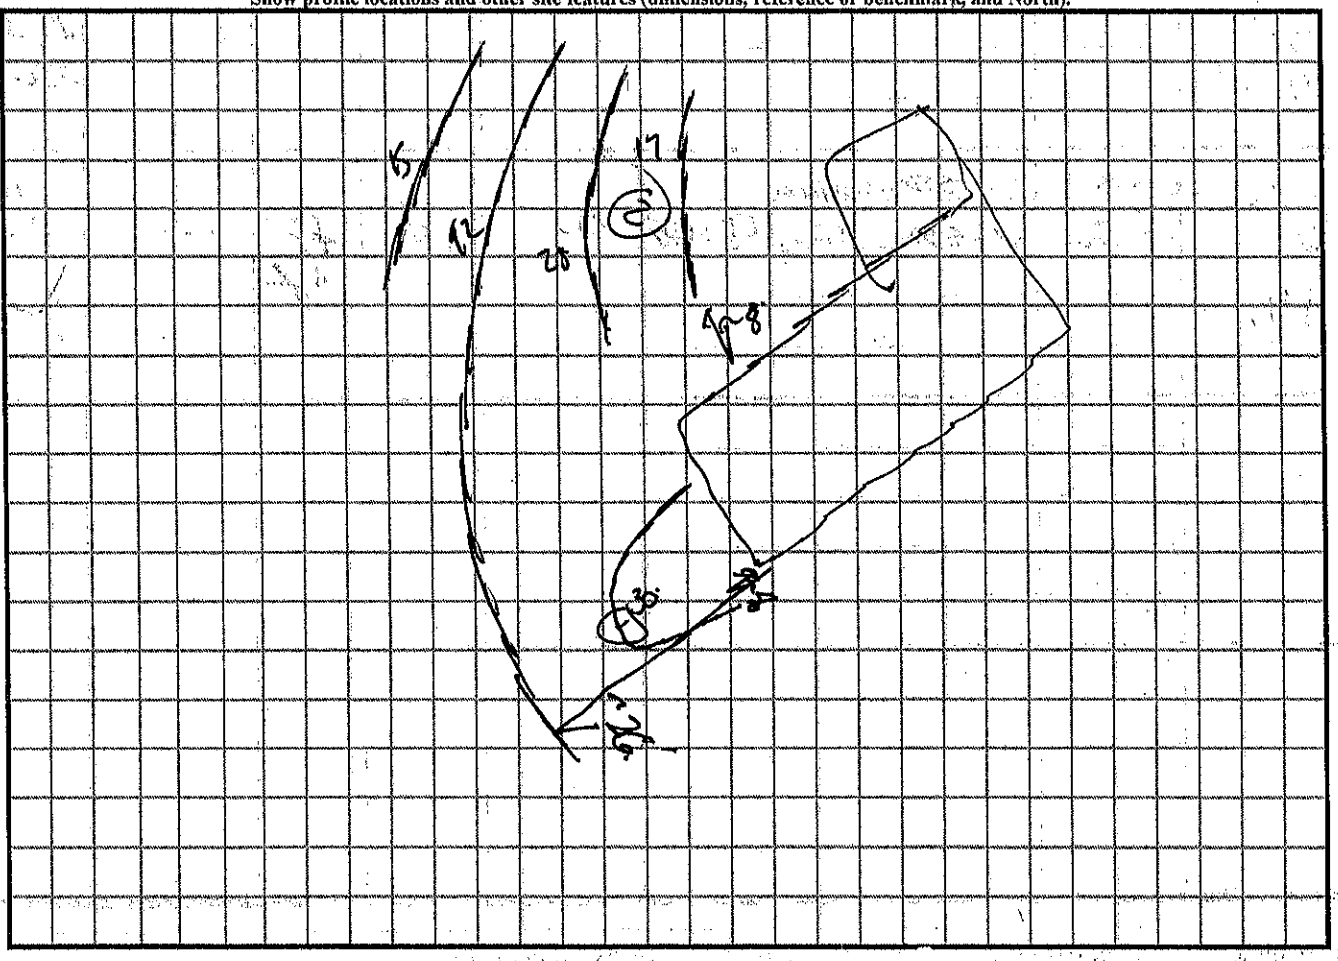

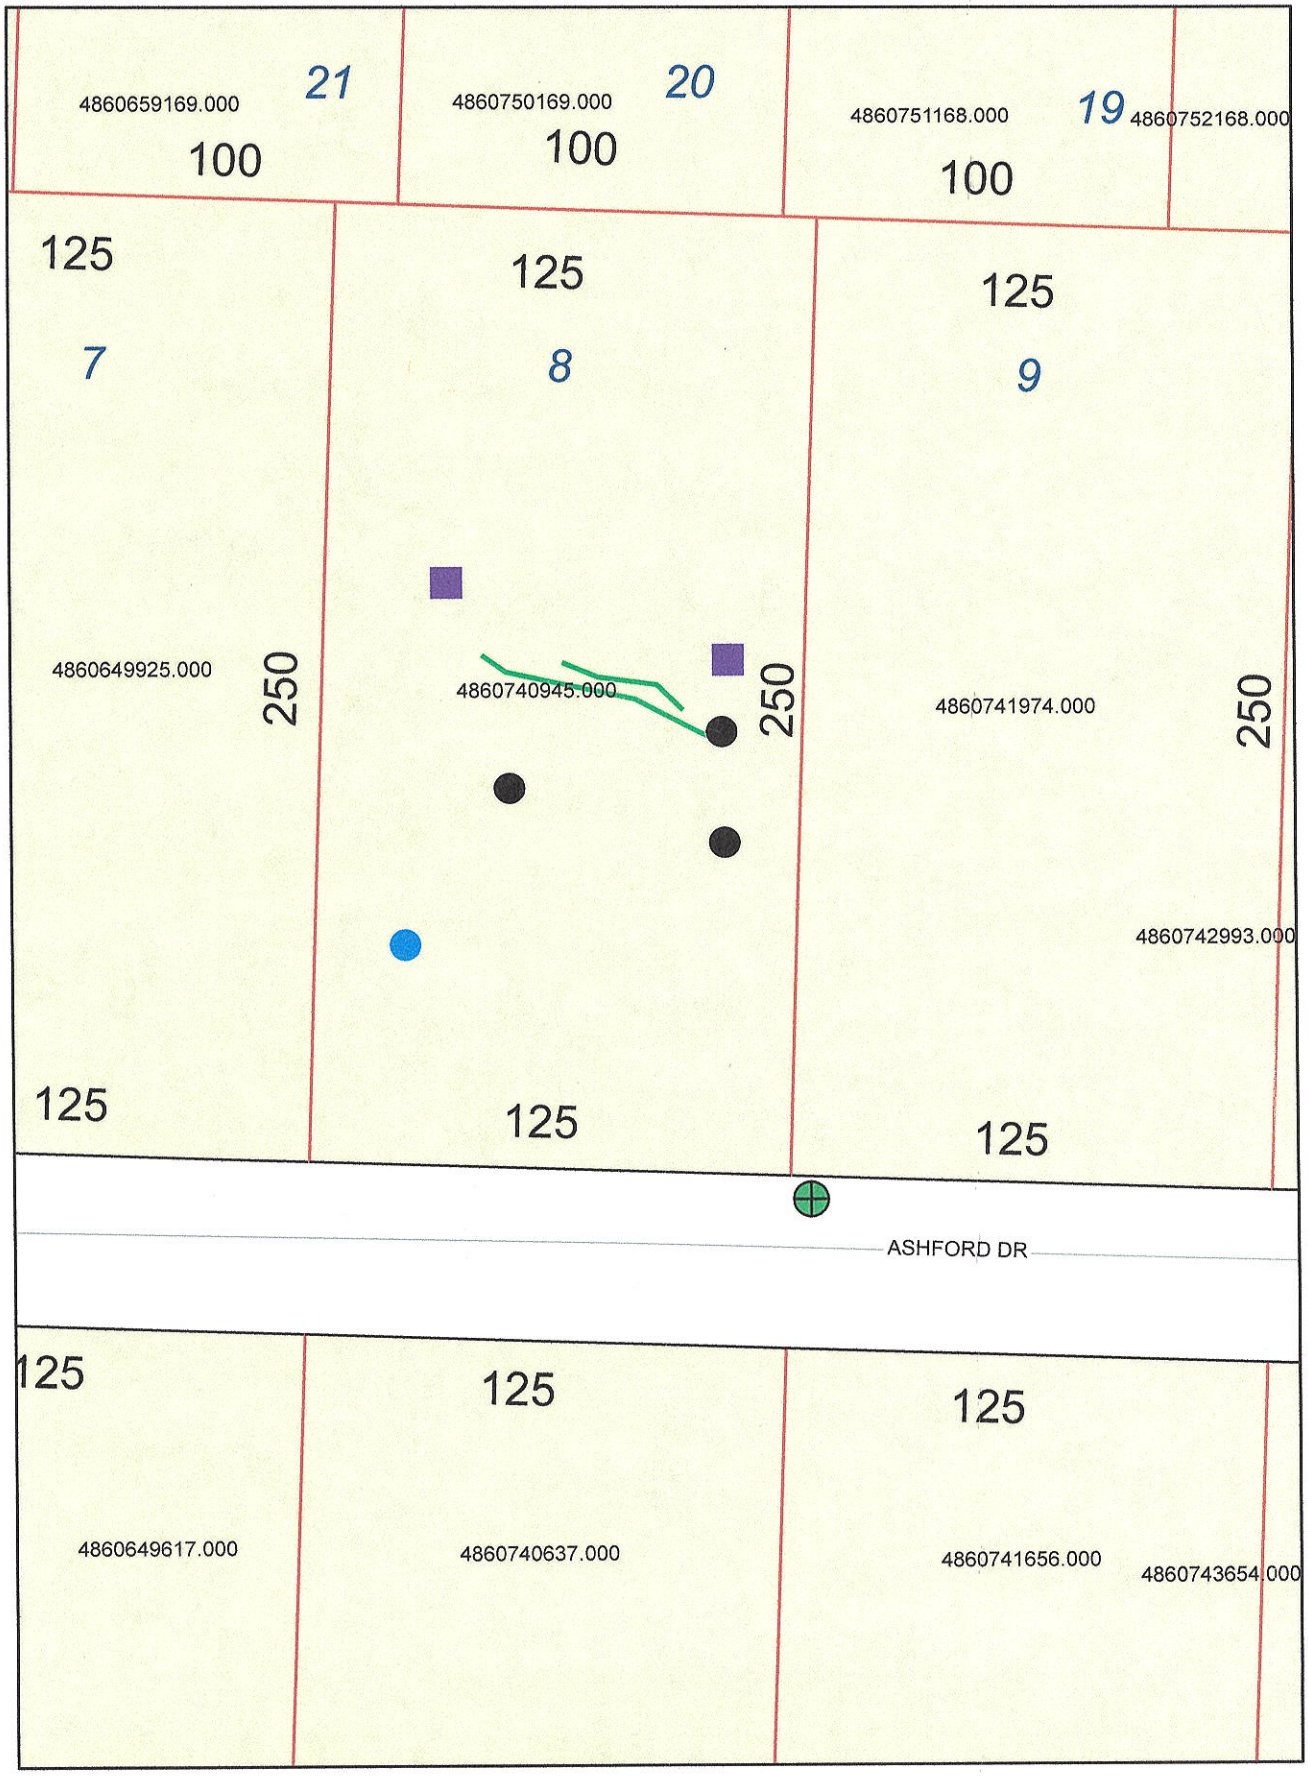
4860659169.000
21
100
4860750169.000
20
100
4860751168.000
19
100
4860752168.000
125
7
125
8
125
9
4860649925.000
250
4860740945.000
250
4860741974.000
250
4860742993.000
125
125
125
ASHFORD DR
125
4860649617.000
125
4860740637.000
125
4860741656.000
4860743654.000

RECEIVED APR 1 - 2022

COMPREHENSIVE LAYOUT AP- 316017 Comprehensive Relayout

IREDELL COUNTY DEPARTMENT of ENVIRONMENTAL HEALTH

APPLICATION FORM

Paid $500.00

Application For: ( ) New Well Permit ( ) Well Repair Permit ( ) Well Abandonment
(✓) Septic Improvement Permit (✓) Authorization to Construct ( ) Existing System Inspection ( ) Septic System Repair

THE ABOVE PERMIT DOCUMENTS WILL BECOME INVALID IF INFORMATION PROVIDED ON THIS APPLICATION IS FALSIFIED OR CHANGED, OR IF THE SITE IS ALTERED. THE IMPROVEMENT PERMIT IS VALID FOR EITHER 60 MONTHS OR WITHOUT EXPIRATION DEPENDING UPON DOCUMENTATION SUBMITTED. APPLICATION WITH SITE PLAN 60 MONTHS, APPLICATION WITH COMPLETE, SCALED PLAT WITHOUT EXPIRATION. SEE 15A NCAC 18A .1937(f) FOR DETAILS.

Page 2: *Site Plan Worksheet* form MUST accompany this application

The following optional attachments may also be submitted: ( ) Survey Plat, scaled no more than 1 inch = 60 feet
Place an (X) beside whichever is submitted if applicable ( ) Custom Site Plan, scaled no more than 1 inch = 60 feet

Applicant Information: (PRINT CLEARLY)

Applicant Name: Jeanne Moulton Address: PO Box 33306, Charlotte NC Zip: 28233
Applicant Email: jeanne@peakmgtgroup.com Phone: 980-215-3837 Alt. Phone: 704-885-0488
Owner Name: Optimistic Venture Group Address: PO Box 33306 Charlotte NC Zip: 28233
Owner Email: jeanne@peakmgtgroup.com Phone: 980-215-3837 Alt. Phone: 704-885-0488

Property Information:

Street Address: 149 Ashford Dr. Olin, NC 28660
Subdivision Name: Holly Ridge Section/Phase: _____ Lot Number: _____
Driving Directions: I-77N to Tomlin Rd Exit 59; (R) on Tomlin Rd, (L) on Tabor Rd, (R) on Ashford Dr.

Site Development Information: *(check or complete ALL that apply*

(✓) New Single Family Residence — Maximum Number of Bedrooms: 3
( ) New Multi-Family Residence — Maximum Number of Occupants: 5
( ) Accessory Building — ( ) Swimming Pool
( ) Bedroom(s) Addition — ( ) Other Addition/Structure: _____
( ) Repair to failing septic system ___ Tank ___ Drain lines Describe Problem: _____

CHECK FOUNDATION TYPE
( ) Crawl Space Foundation
( ) Concrete Slab Foundation
( ) Basement with Plumbing
( ) Basement without Plumbing

Non-Residential Site Development: Type of Business: _____
Square Footage of Building: 2320 Max. Number of Employees: _____ Max. Number of Seats/Beds/Other: _____

Water Supply: ( ) Replacement Well – Reason: _____
( ) Multi-connection Well Number of Houses: _____ Number of Persons: _____
( ) New Well ( ) Existing Well ( ) Community Well ( ) City Water (✓) Other Public Water Iredell Water Corp.

Desired Septic System Type: *(you may rank in order of preference)* Year existing system installed: 2022
( ) No Preference ( ) Alternative (✗) Conventional ( ) Innovative ( ) Modified Conventional ( ) Other: _____

Please answer the following to the best of your ability:
( ) Yes (✗) No Does the site contain any jurisdictional wetlands?
( ) Yes (✗) No Is any non-domestic sewage (i.e. industrial) to be generated?
( ) Yes (✗) No Is the site subject to approval by any other public agency?

I have read this application and certify that the information provided herein is true, complete, and correct. Authorized county and state officials are granted right of entry to conduct necessary inspections to determine compliance with applicable laws and rules. I understand that I am solely responsible for the proper identification and labeling of all property lines and corners and making the site accessible so that a complete site evaluation can be performed.

Signature: Jeanne M. Moulton 3/31/2022
Property owner or owner's legal representative signature (SIGNATURE REQUIRED) DATE

IREDELL COUNTY DEPARTMENT OF ENVIRONMENTAL HEALTH

DOCUMENTATION TO AUTHORIZE AN OWNER'S LEGAL REPRESENTATIVE

(Check and sign only ONE of the options below)

1. *** APPLICANT AND OWNER ARE THE SAME. *** (*Sign here*) _____

Applications for permits require the "signature of the owner or owner's legal representative" (15A NCAC 18A .1937). If the owner does not sign the application himself or herself, they can submit any one of the following documents to designate their legal representative: *Power of Attorney; Real Estate Contract; Estate executor; Bankruptcy trustee; Court ordered guardianship*
In the absence of the above documentation, the property owner may provide the local health department with documentation that designates a legal representative. A property owner may:
Complete this form to document his or her legal representative, or provide his or her own form that contains the information in this form. If there are multiple property owners, then all property owners must sign the form that designates a legal representative.
By signing a form that designates a legal representative for purposes of 15A NCAC 18A .1937, the property owner authorizes that representative to act on their behalf in matters pertaining to the application and permitting process, including signing or receiving any application, document or permit. The owner retains full responsibility to meet all permit conditions specified by the local health department.

2. I, Optimistic Venture Group, am the legal owner(s) of the property located at 149 Ashford Dr. Olin, NC 28660, identified as

PIN (Parcel Identification Number) 4860-74-0945, located in Iredell County, North Carolina.

I do hereby authorize (**print legal representative/company name**) Jeanne Moulton, and Frank Allen, to act as an agent on my behalf in applying for/signing/obtaining any of the documents described below.

- Application for Improvement Permit (IP) / Authorization to Construct (AC)
- Improvement Permit (IP) / Authorization to Construct (AC)
- Application for soil-site evaluation (new/repair)
- Application/permit for private drinking water well/well abandonment
- Application for Compliance Inspection

I agree to abide by all decisions and/or conditions between the legal representative acting on my behalf and the Iredell County Department of Public Health, Environmental Health Division.

_____ 3-31-22

Signature of Owner(s) Date


Mooresville - Environmental Health
ronda.hart@co.iredell.nc.us
Fax: 704-662-3239
610 E. Center Avenue, Mooresville, NC 28115

Statesville - Environmental Health
adrienne.shea@co.iredell.nc.us
Fax: 704-871-3483
349 N. Center Street, Statesville, NC 28677

IREDELL COUNTY DEPARTMENT of ENVIRONMENTAL HEALTH

SITE PLAN WORKSHEET

SEE THE "SAMPLE SITE PLAN" BELOW. *INCOMPLETE SITE PLANS WILL BE RETURNED TO YOU FOR COMPLETION AND MAY RESULT IN A DELAY IN THE ISSUANCE OF YOUR SEPTIC SYSTEM OR WELL PERMIT*!!!

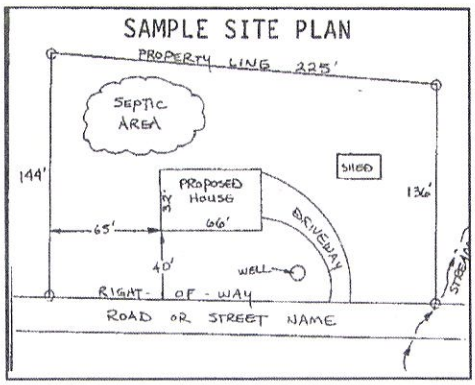

Place an (X) beside each item as you complete the site plan:


- (X) **Property Line measurements are clearly identified**
- (X) **All proposed structures are indicated**
- (X) **Front and side setbacks from property line**
- (X) **Preferred driveway location**
- (X) **Preferred well location**
- (X) **Preferred septic system location**
- (X) **North arrow, or other sufficient indicator of direction**

Circle N/A on the following if appropriate:

- **Location of septic systems and wells within 100' of your property** (N/A)
- **Location of easements and rights of ways on your property** (N/A)
- **Location of any designated wetlands on the property** (N/A)

USE THIS SPACE TO DRAW YOUR SITE PLAN

Show: proposed house or business footprint, wells, water lines, patios, pools and decks, and any other item that will occupy space on the site

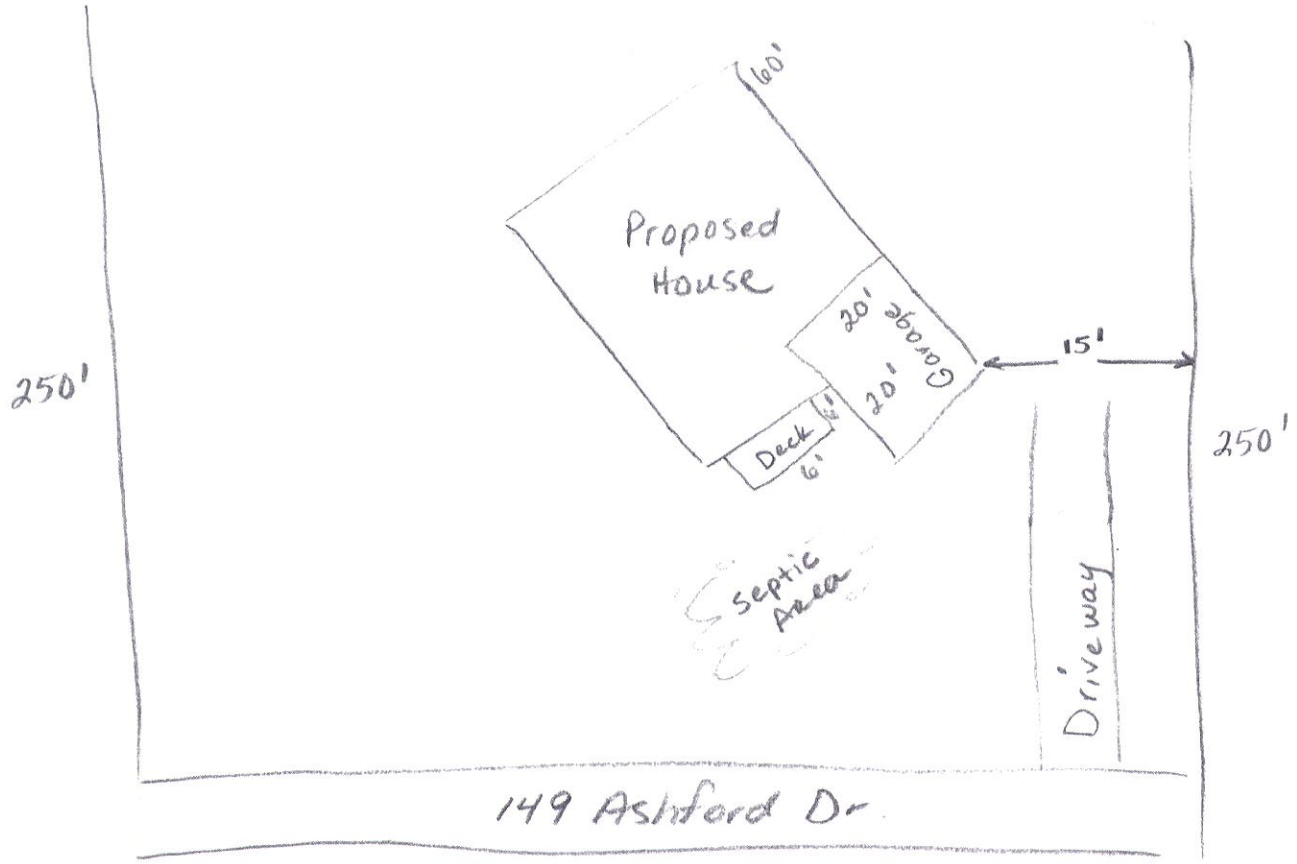

Signature: Jeanne M. Moulton

Property owner or owner's legal representative signature (SIGNATURE REQUIRED)

3/31/2022

DATE

ICHD - ENVIRONMENTAL HEALTH DIVISION

Statesville Office (704) 878-5305 Mooresville Office (704) 660-3625 PERMIT # AP 316017.

SEPTIC: IMPROVEMENT PERMIT / AUTHORIZATION TO CONSTRUCT / OPERATION PERMIT / EXISTING SYSTEM

PIN # 4860740945-- --

APPLICANT/OWNER: Freedom Homes - John Stowe APPLICANT ADDRESS: 1124 Charlotte Hwy Trautman NC 28166

SITE ADDRESS: 149 Ashford Drive Olin NC 28660 PHONE: 704-881-2326 ALT. PHONE —


SITE DIRECTIONS: I-40 to I-77 exit 59 @ Tomlin Mill @ on Tabor @ Ashford 149 on left SAP CONTROLLED: ☐ YES ☒ NO

SUBDIVISION: Holly Ridge SECTION: — LOT # 8 LOT AREA: .73 DESIGN FLOW: 360 L.T.A.R.: .30

Septic Tank 1000 (gal)	STB 760	Date 3/4/22	☒ New System ☐ Repair ☐ Expansion System Type: I II III IV V VI	☒ Residence	No. Bedrooms 3	Water Supply
Pump Tank — (gal)	PT	Date	System Description: Gravity 25% Reduction	☐ Business	No. Persons 6	☐ Private
Pump Make —	Model	Serial #	Repair System Description: LP-Panel 50% Reduction	☐ Other	No. Employees	☒ Public
# Nitrification Fields 1	# Lines 5	Linear Ft 300	Maintenance Agreement Required: ☐ YES ☒ NO	☐ Slab	☒ Crawl Space	☐ Community
Trench Width 36	Trench Bottom Depth 36in max	Gravel Depth —	☒ GRAVITY ☐ PRESSURE	☐ Basement w/ plumbing	☐ Basement w/o plumbing	


Comments / Conditions: Install on the contour of the land and utilize Serial Distribution. Do not exceed max depth of 36 inches. Do not Drive, Park, park, or grade Drainfield Area.

INITIAL SITE SKETCH

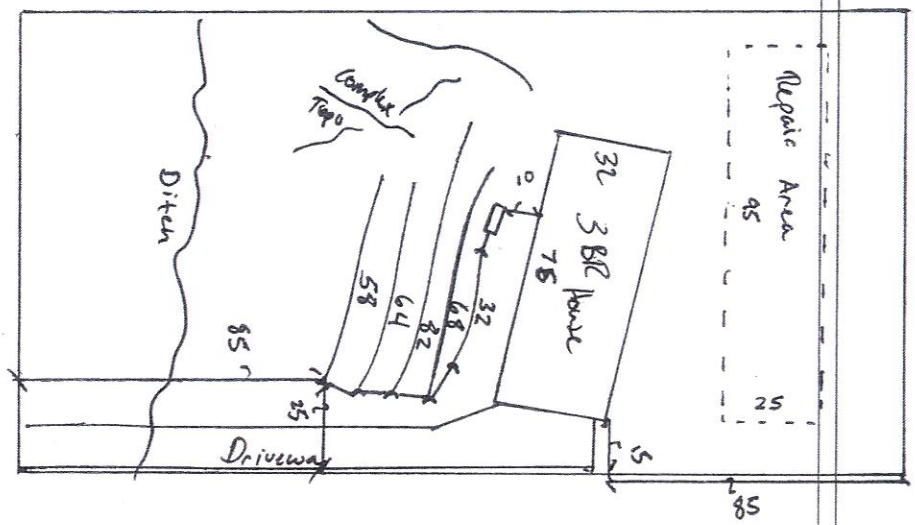

AS BUILT SKETCH

FOR SEPTIC FINAL INSPECTION CALL: 704-664-3703 between 8am-9am the day the inspection is needed. Be sure to speak with an inspector to confirm your time.

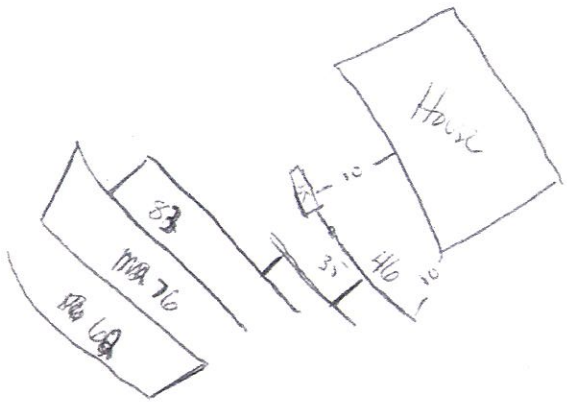

Reworked 6-6-22

Need Comprehensive Repair Area Gone

Permit can be suspended or revoked if any false information is supplied toward securing the permit / any unauthorized changes are made to the site / any unauthorized changes are made in the installation of the system. CONDITION no.

☐ IMPROVEMENT PERMIT *with plat valid without expiration.* ☒ IMPROVEMENT PERMIT *with site plan valid for 60 mos.* ☒ AUTHORIZATION TO CONSTRUCT *valid for period equ*

Owner / Applicant Signature: Jeanne M. Moulton owner Optimistic Venture Group Date: 9/24/2021 Installed by: Maiden Grading

IMPROVEMENT PERMIT by: Benjamin A. Bell Date: 5-6-2021 OPERATION PERMIT by: Date:

AUTHORIZATION TO CONSTRUCT by: Benjamin A. Bell Date: 9-10-2021 Existing System Inspected by: Date:


FOR SEPTIC FINAL INSPECTION: CALL 704-664-3703 between 8am-9am the day the inspection is needed.

Clayton Belmont

Acknowledgement Of
Plans Submittal ONLY!

Renee Walters Date 9/8/2021

Bonnie White Date 9-10-2021

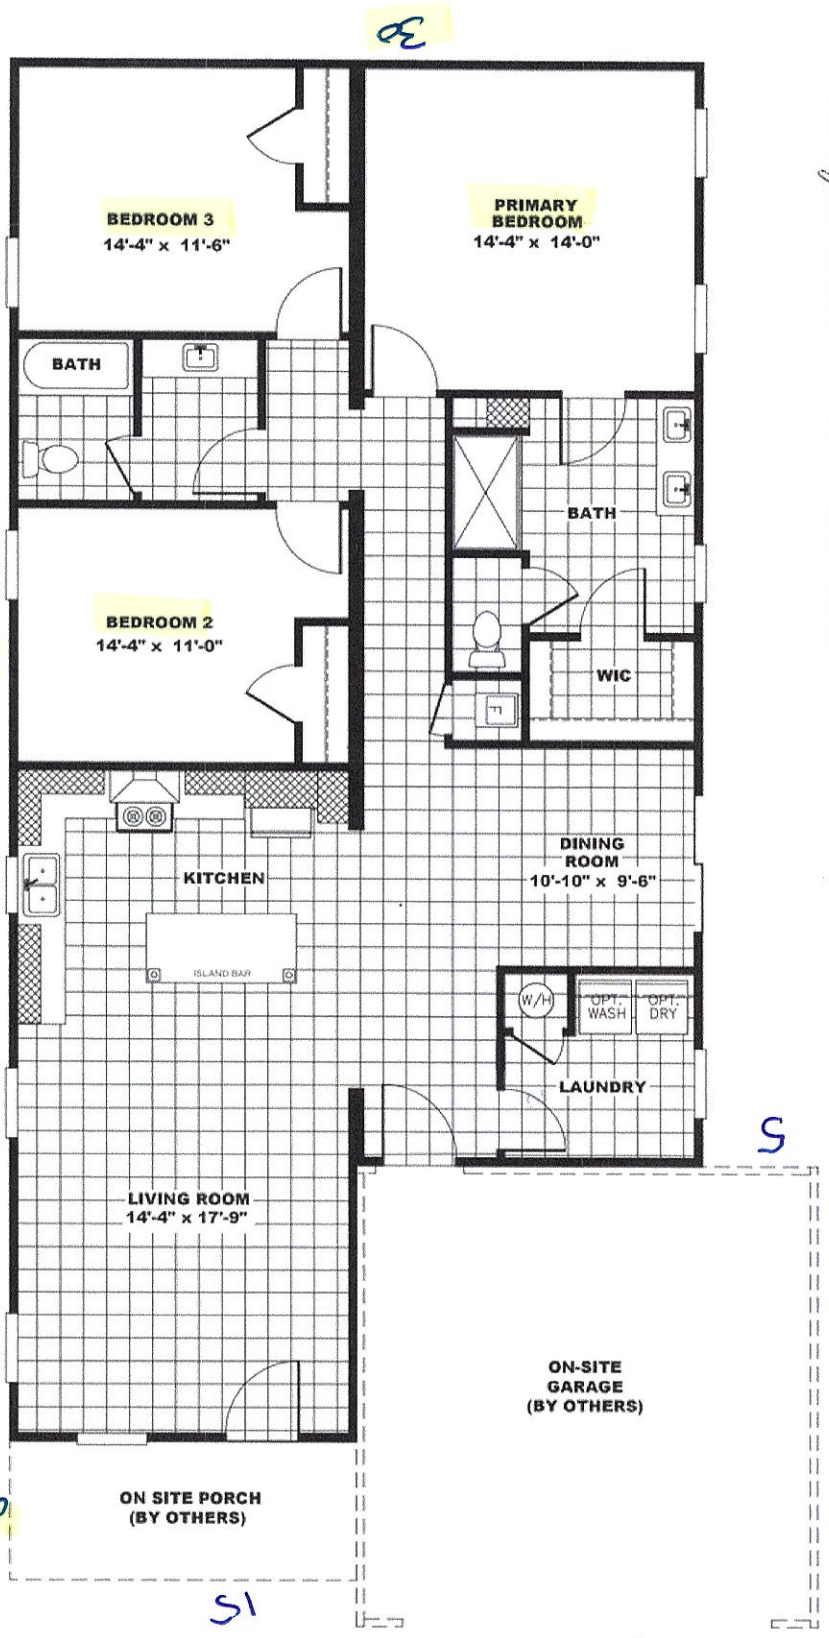

IREDELL COUNTY
PO Box 788
349 North Center St.
Statesville, NC 28677

APPLICATION NUMBER
316017 Issue Date:

Permit Type: ZONING

Parcel Number	Street Address	Jurisdiction
4860740945.000	149 ASHFORD DR	IREDELL COUNTY

Owner Information	Applicant Information
Name: STOW JOHN S+LINDA K	Name: FREEDOM HOMES-TROUTMAN #667- USE THIS ONE
Address:	Address: 1124 CHARLOTTE HWY TROUTMAN, NC 28166
Phone:	Phone: (704)528-7960

Use Requested	Zone Code
Modular	RA

Lot Acreage	F Setback	B Setback	L Setback	R Setback	Watershed	Flood Zone
0.73	35	35	15	15		NO

Remarks
MODULAR

The applicant certifies that there are no deed restrictions, contractual agreements or governmental regulations of any kind that interfere with or prohibit the use of the property or the use for which this permit is requested. The applicant further acknowledges that enforcement of deed restrictions, plat conditions and other contractual agreements will not be undertaken by Iredell County and is the sole responsibility of the affected parties.

Date: 03/22/2021

Signature of Owner/Contractor

Permit Number	316017	TOTAL FEES:	$77.25