THIS PERMIT VOIDS PREVIOUS ISSUED 11-8-2000

IREDELL COUNTY HEALTH DEPARTMENT

STATESVILLE 704-878-5305 MOORESVILLE 704-664-5281

IMPROVEMENT PERMIT / AUTHORIZATION TO CONSTRUCT / OPERATION PERMIT / EXISTING SYSTEM INSPECTION

PERMIT# 92871 PIN# 4860 74 2322 DATE 1-9-01

OWNER OR CONTRACTOR DAN & RITA CONRAD PHONE: Business Home 873-2547

ADDRESS 2026 NORTHSIDE DR, STATESVILLE, NC 28625

LOCATION US 21 N, TL TABOR RD, TR ASHFORD DRIVE, LOT MIDWAY ON RIGHT

SUBDIVISION Holly Ridge BLOCK / SECTION LOT 26 LOT AREA 0.73 ACRES SITE CLASS P5 DESIGN FLOW 360 L.T.A.R. 0.30 GAD/FT2

Septic Tank: 1000 Gallons: STB 825 Date 6-21-00

Pump Tank: Gallons: PT Date

Pump Make: Model Serial No.

Nitrification Field: No Fields 1 Square Feet ~~1200~~ 1200 Linear Feet ~ 210

No Lines SIX Trench Width 24" Max Trench Bottom Depth 36" ~~Gravel~~ Depth SAND 6"

☑ New System ☐ Repair System Type: I, II, (III), IV, V, VI

System Description: 50% REDUCTION GRAVITY

Repair System Description: 50% REDUCTION PUMP

Maintenance Agreement Required: ☐ Yes ☑ No

~~☐~~ House/Mod. Home ☐ Mobile Home ☐ Business ☐ Other

No. Bedrooms 3 No. Bathrooms 2 No. Employees


☐ Slab ☑ Crawl Space ☐ Basement w/plumbing ☐ Basement wo/plumbing

Water Supply: ☐ Individual ☑ Public ☐ Community


Comments/Conditions: ① INSTALL 48 PPGPS PANELS IN SIX EQUAL LENGTH LINES ② USE ONE FLOW DIVIDER TEE TO ACHIEVE EQUAL DISTRIBUTION INTO TWO SETS OF DROP BOXES FOR SERIAL DIST. INTO 3 LINES EACH

Comments/Conditions: SEPTIC TANK WITH RISERS INSTALLED USING "POLYLOK" FILTER

INITIAL SITE SKETCH

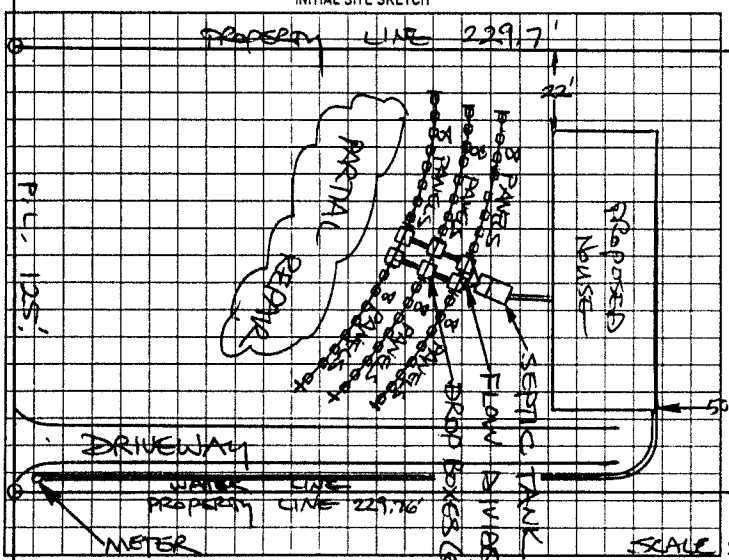

AS BUILT SKETCH

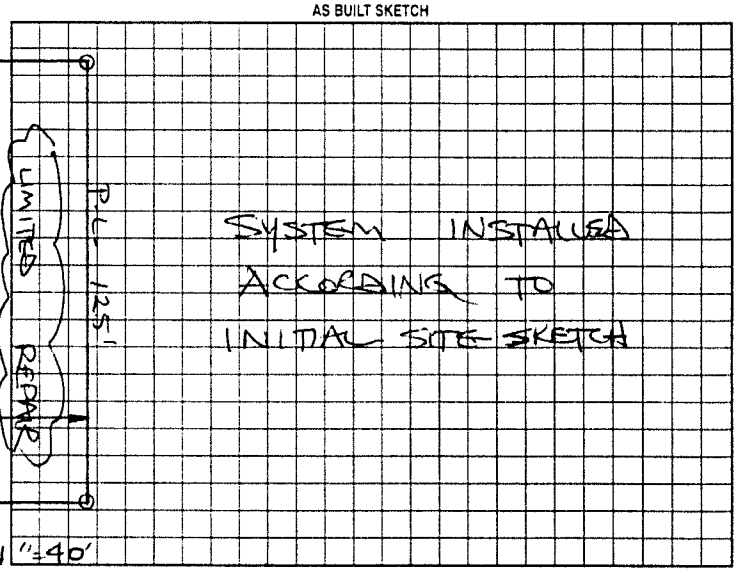

SCALE: 1"=40'

Permit can be suspended or revoked if any false information is supplied toward securing the permit/any unauthorized changes are made to the site/any unauthorized changes are made in the installation of the system. Improvement Permit with plat valid without expiration. Improvement Permit with site plan valid for sixty months. Authorization to Construct is valid for a period equal to that of Improvement Permit - not to exceed sixty months.

Signed: C.W. Gurley + Son, Inc. date

Improvement Permit by: STEVE HENDRICK date 1-9-01

Authorization to Construct by: STEVE HENDRICK date 1-9-01

Installed by: STATESVILLE BACKHOE

Operation Permit by: STEVE HENDRICK date 1-29-01

Existing System Inspection by: date

HEALTH DEPT. COPY WHITE OWNER COPY (FINAL) YELLOW OWNER COPY (INITIAL) PINK