IREDELL COUNTY HEALTH DEPARTMENT

STATESVILLE 704-878-5305 MOORESVILLE 704-664-5281

IMPROVEMENT PERMIT / AUTHORIZATION TO CONSTRUCT / OPERATION PERMIT / EXISTING SYSTEM INSPECTION

PERMIT# 86583 PIN# 4860742322 DATE 12-14-99

OWNER OR CONTRACTOR Phil Smithson PHONE: Business Home 704 896 8039

ADDRESS 20618 Cornelius St. Cornelius N.C.

LOCATION 21 N TL Tabor Rd TR Valley Spring near ent on Rt.

SUBDIVISION Holly Ridge BLOCK / SECTION 2 LOT 51 LOT AREA .75acres SITE CLASS PS DESIGN FLOW 360 L.T.A.R. .3 gal/sq ft/day

Septic Tank: 1000 Gallons; STB 1012 Date 10-8-99
Pump Tank: Gallons; PT Date
Pump Make: Model Serial No.
Nitrification Field: No Fields 1 Square Feet 900 Linear Feet 300
No Lines 4 Trench Width 36" Max Trench Bottom Depth 36" Gravel Depth N/A

☑ New System ☐ Repair System Type: I, II, III, IV, V, VI
System Description: Gravity 25% Reduction
Repair System Description: Pump to 25% Reduction
Maintenance Agreement Required: ☐ Yes ☑ No


☑ House/Mod. Home No. Bedrooms 3
☐ Mobile Home No. Bathrooms 2
☐ Business No. Employees
☐ Other

☐ Slab ☐ Crawl Space ☐ Basement w/plumbing ☐ Basement wo/plumbing

Water Supply: ☐ Individual ☑ Public ☐ Community


Comments/Conditions: valley sp. Drive

INITIAL SITE SKETCH

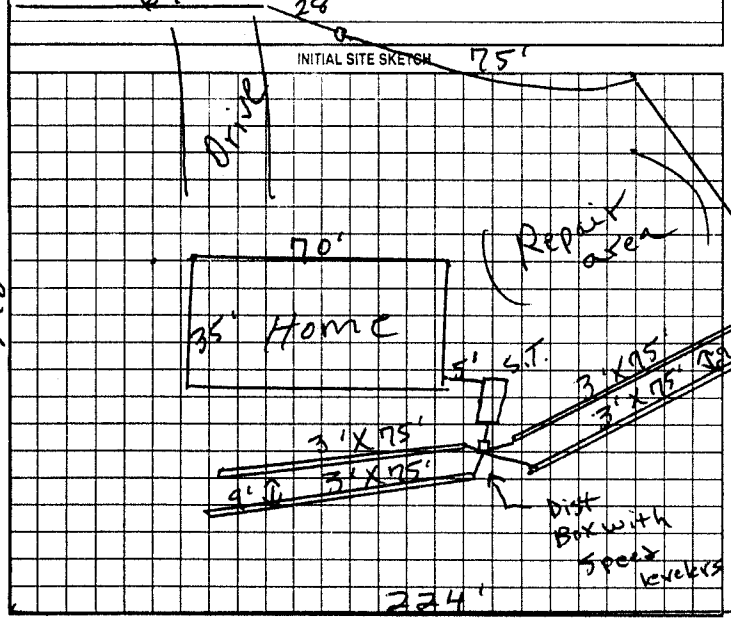

Comments/Conditions:

AS BUILT SKETCH

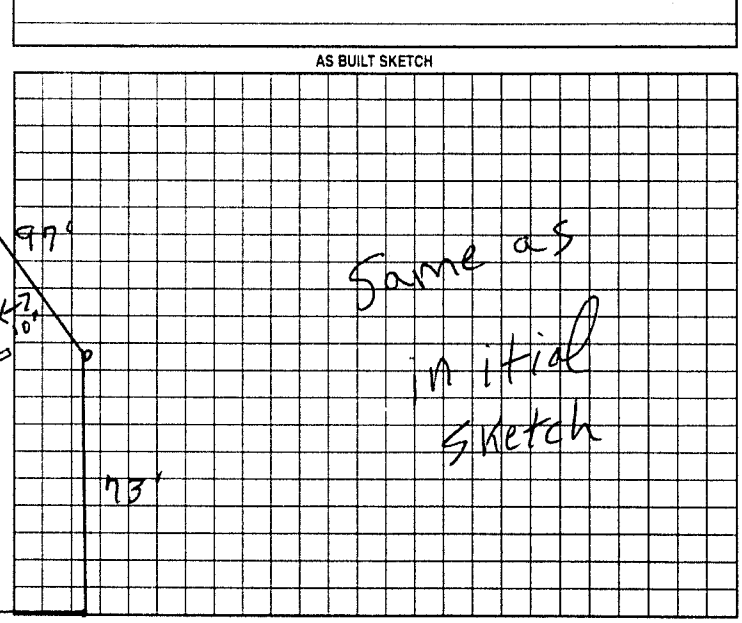

Permit can be suspended or revoked if any false information is supplied toward securing the permit/any unauthorized changes are made to the site/any unauthorized changes are made in the installation of the system. Improvement Permit with plat valid without expiration. Improvement Permit with site plan valid for sixty months. Authorization to Construct is valid for a period equal to that of Improvement Permit – not to exceed sixty months.

Signed: Phil Smithson date 12-15-99 Installed by: Craig Thompson

Improvement Permit by: P.C. moore date 12-14-99 Operation Permit by: P.C. moore date 1-14-00

Authorization to Construct by: P.C. moore date 12-14-99 Existing System Inspection by: date

HEALTH DEPT. COPY: WHITE OWNER COPY (FINAL): YELLOW OWNER COPY (INITIAL): PINK