IREDELL COUNTY HEALTH DEPARTMENT

STATESVILLE 704-878-5305 (CN) MOORESVILLE 704-664-5281

IMPROVEMENT PERMIT / AUTHORIZATION TO CONSTRUCT / OPERATION PERMIT / EXISTING SYSTEM INSPECTION

PERMIT# 106531 PIN# 4860-74-9308 DATE 6-4-02

OWNER OR CONTRACTOR AMY McCULLOUGH PHONE: Business Home 704-872-9245

ADDRESS 123 WATERING TROUGH ROAD, STATESVILLE, NC 28677

LOCATION US 21 NORTH, TL TABOR RD TR VALLEY SPRINGS DRIVE, LOT ON LEFT BEFORE CUL-DE-SAC

SUBDIVISION HOLLY RIDGE BLOCK / SECTION LOT 47 LOT AREA 0.73 ACRE SITE CLASS PS1 DESIGN FLOW 360 L.T.A.R. 0.25 GPD/FT²

Septic Tank: 1000 Gallons; STB 1012 Date 11-10-02
Pump Tank: Gallons; PT Date
Pump Make: Model Serial No.
Nitrification Field: No Fields 1 Square Feet EQ TO 1440 Linear Feet 240
No Lines SIX Trench Width 24" Max Trench Bottom Depth 36" ~~Gravel~~ Depth 6" SAND

☑ New System ☐ Repair System Type: I, II, (III), IV, V, VI
System Description: 50% REDUCTION, GRAVITY
Repair System Description: 50% REDUCTION, LOW-PRESSURE
Maintenance Agreement Required: ☐ Yes ☑ No


☑ House/Mod. Home No. Bedrooms 3
☐ Mobile Home No. Bathrooms 2
☐ Business No. Employees
☐ Other
☐ Slab ☑ Crawl Space ☐ Basement w/plumbing ☐ Basement wo/plumbing

Water Supply: ☐ Individual ☑ Public ☐ Community


Comments/Conditions: (1) INSTALL SUBSURFACE INTERCEPT DRAINAGE DITCH AS SHOWN BEGINNING 48" DEEP, AROUND SYSTEM, THEN OUT TO DAYLIGHT (2) INSTALL 50% REDUCTION SYSTEM USING 54 PPBPS PANELS IN SIX EQUAL LENGTH LINES,

Comments/Conditions: SEPTIC TANK WITH MARKER INSTALLED USING "TUFFTITE" FILLER

INITIAL SITE SKETCH

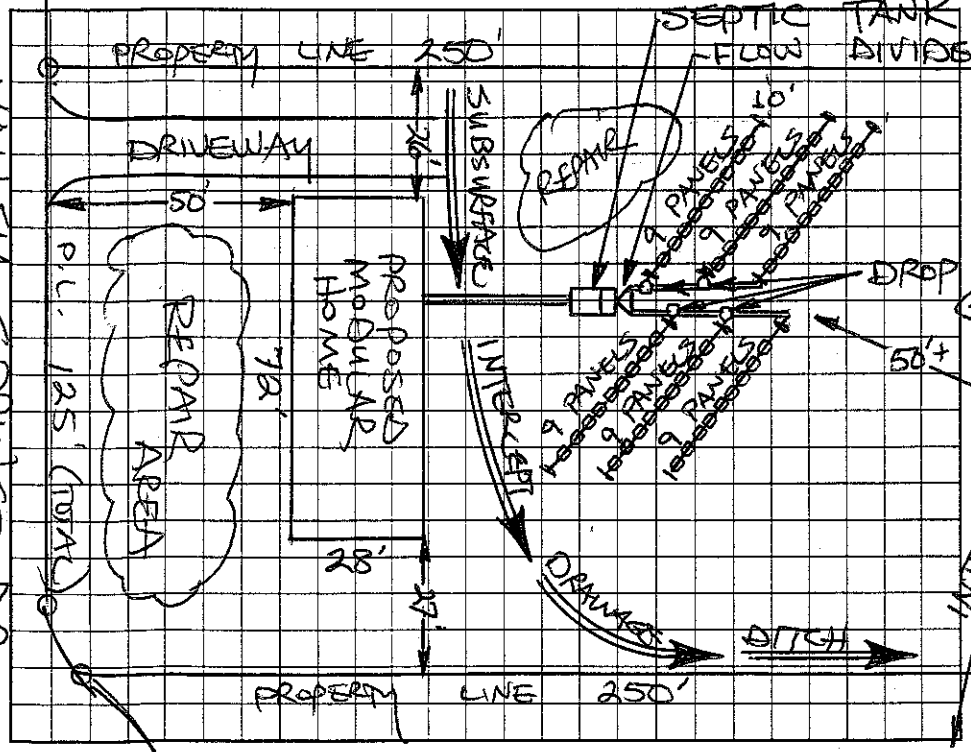

AS BUILT SKETCH

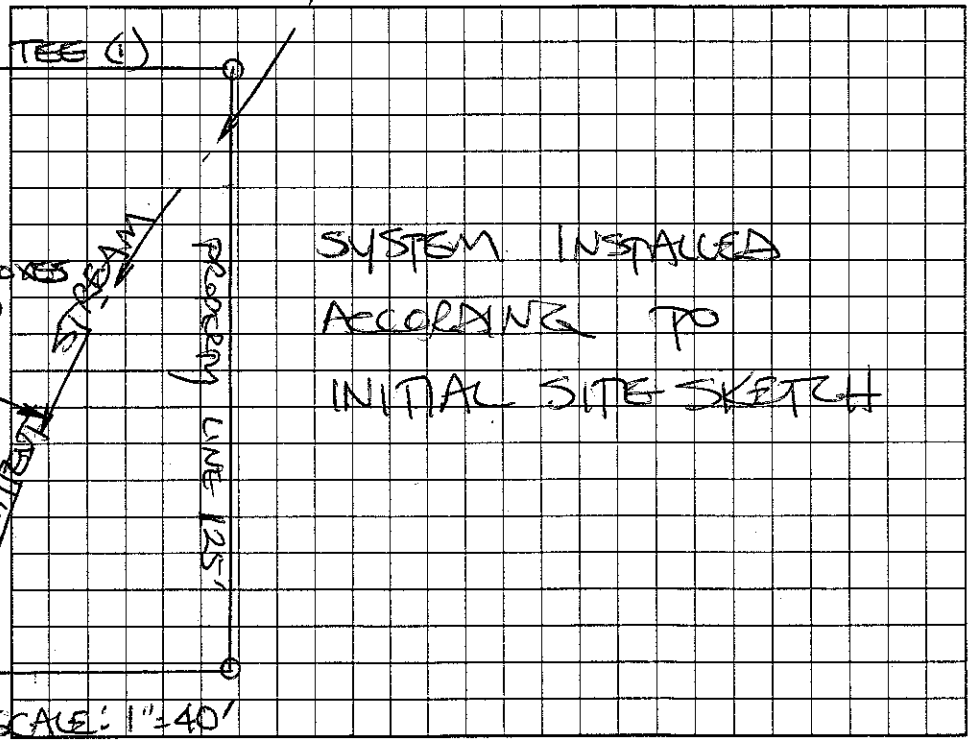

Permit can be suspended or revoked if any false information is supplied toward securing the permit/any unauthorized changes are made to the site/any unauthorized changes are made in the installation of the system. Improvement Permit with plat valid without expiration. Improvement Permit with site plan valid for sixty months. Authorization to Construct is valid for a period equal to that of Improvement Permit – not to exceed sixty months.

Signed: Amy McCullough date 6-11-02 Installed by: TOMMY FRYE

Improvement Permit by: STEVE HEDRICK date 6-4-02 Operation Permit by: STEVE HEDRICK date 1-14-03

Authorization to Construct by: STEVE HEDRICK date 6-4-02 Existing System Inspection by: date

HEALTH DEPT. COPY: WHITE OWNER COPY (FINAL): YELLOW OWNER COPY (INITIAL): PINK