IREDELL COUNTY HEALTH DEPARTMENT

STATESVILLE 704-878-5305 MOORESVILLE 704-664-5281

IMPROVEMENT PERMIT / AUTHORIZATION TO CONSTRUCT / OPERATION PERMIT / EXISTING SYSTEM INSPECTION

PERMIT# 117409 PIN# 4860-74-9922 → 828-464-8715 DATE 2-11-04

OWNER OR CONTRACTOR EDDLEMAN REALTY INC./OAKWOOD HOMES PHONE: Business 704-252-0911 Home

ADDRESS 403 E. FRONT ST. STATESVILLE 28677

LOCATION 21N @ TABOR ® ASHFORD LOT 15 @ END ON (L)

SUBDIVISION HOLLY RIDGE BLOCK / SECTION 2 LOT 15 LOT AREA .73 SITE CLASS. PS DESIGN FLOW 360 L.T.A.R. .36GPD/FT²

Septic Tank: 1000 Gallons; STB 786 Date 11-18-03
Pump Tank: Gallons; PT Date
Pump Make: Model Serial No.
Nitrification Field: No Fields 1 Square Feet 1200 Linear Feet 300
No Lines 4 Trench Width 36" Max Trench Bottom Depth 24" Gravel Depth N/A

☑ New System ☐ Repair System Type: I, II, (III) IV, V, VI
System Description: GRAVITY 25% REDUCTION
Repair System Description: LP PANEL 50% RED.
Maintenance Agreement Required: ☐ Yes ☑ No


☑ House/Mod. Home No. Bedrooms 3
☐ Mobile Home No. Bathrooms 2
☐ Business No. Employees
☐ Other
☐ Slab ☑ Crawl Space ☐ Basement w/plumbing ☐ Basement wo/plumbing

Water Supply: ☐ Individual ☑ Public ☐ Community


Comments/Conditions: ① MAINTAIN ALL SETBACKS ② INSTALL SEPTIC LINES ON CONTOUR

Comments/Conditions: ① POLYLOK FILTER ② EZ-FLOW ③ INSTALLED AS SHOWN.

INITIAL SITE SKETCH

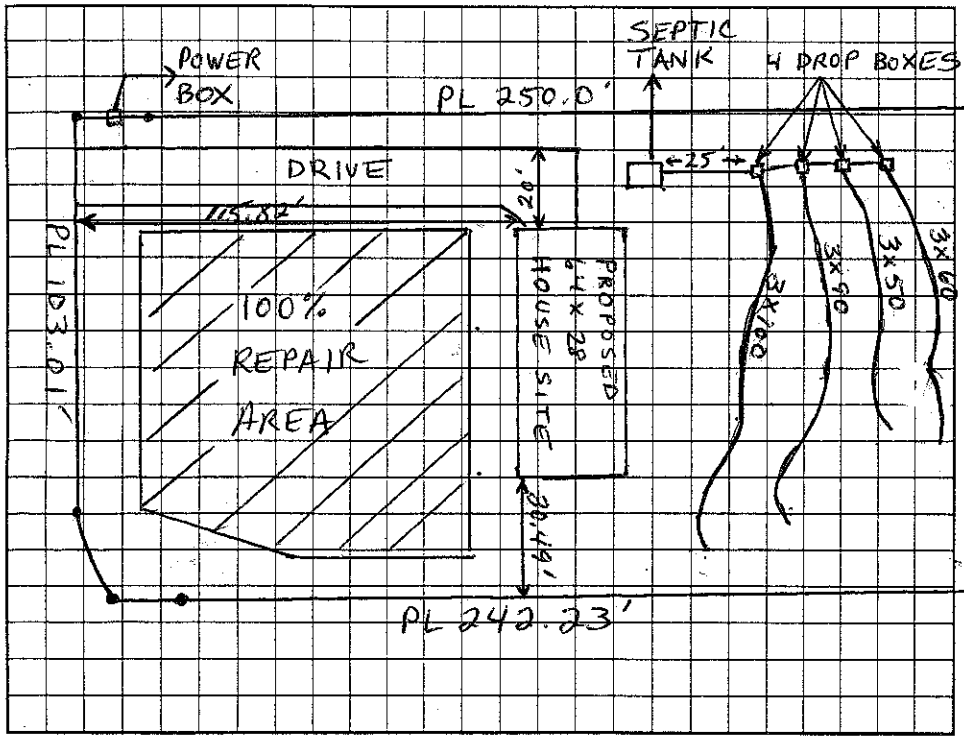

AS BUILT SKETCH

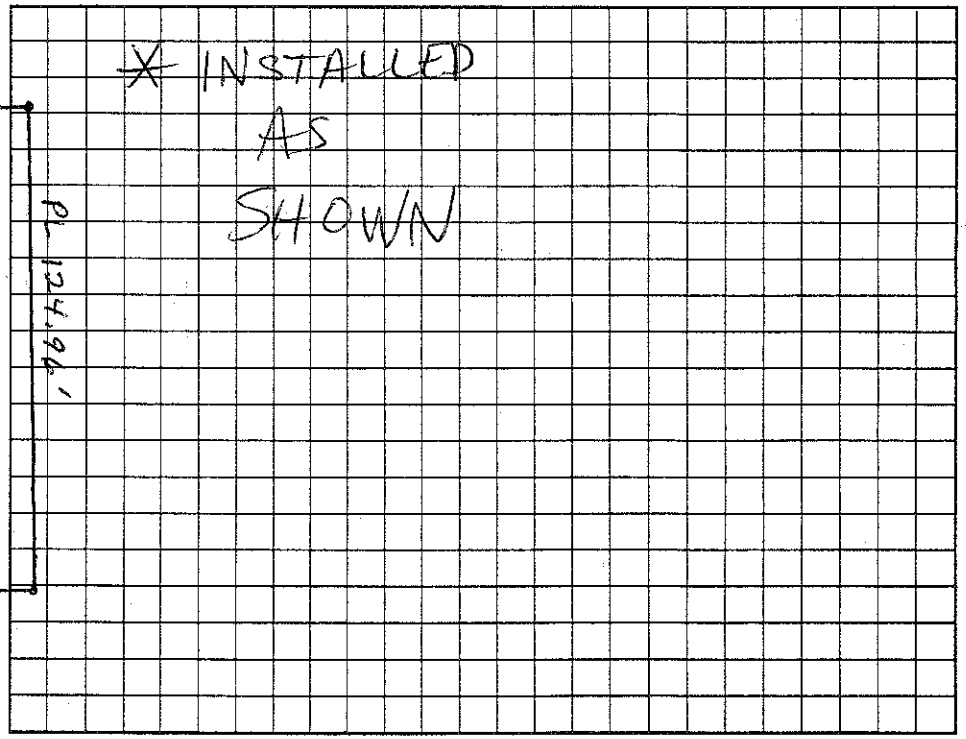

Permit can be suspended or revoked if any false information is supplied toward securing the permit/any unauthorized changes are made to the site/any unauthorized changes are made in the installation of the system. Improvement Permit with plat valid without expiration. Improvement Permit with site plan valid for sixty months. Authorization to Construct is valid for a period equal to that of Improvement Permit – not to exceed sixty months.

Signed: date

Improvement Permit by: Christopher M. Shenill, R.S. date 2-11-04

Authorization to Construct by: Christopher M. Shenill, R.S. date 2-11-04

Installed by: Kanupp's Grading

Operation Permit by: Christopher M. Shenill, R.S. date 2-25-04

Existing System Inspection by: date

HEALTH DEPT. COPY: WHITE OWNER COPY (FINAL): YELLOW OWNER COPY (INITIAL): PINK