IREDELL COUNTY HEALTH DEPARTMENT

STATESVILLE 704-878-5305 MOORESVILLE 704-664-5281

IMPROVEMENT PERMIT / AUTHORIZATION TO CONSTRUCT / OPERATION PERMIT / EXISTING SYSTEM INSPECTION

PERMIT# 12818 PIN# 4860 75 0574 DATE 8-24-05

OWNER OR CONTRACTOR Sandra L Johnson PHONE: Business 704 539-4442 Home

ADDRESS 10310 Stokes Ferry RD

LOCATION 74W - Tomlinson Mill Rd to Tabor RD (TR) Forney LN

SUBDIVISION Forney Acres BLOCK / SECTION LOT 11 LOT AREA SITE CLASS. RS DESIGN FLOW 240 L.T.A.R. .3

Septic Tank: 1000 Gallons; STB 740 Date 8-01-05 ☐ New System ☐ Repair System Type: I, II, III, IV, V, VI ☐ House/Mod. Home No. Bedrooms 2

Pump Tank: Gallons; PT Date System Description: 25% - Gravity ☐ Mobile Home No. Bathrooms

Pump Make: Model Serial No. Repair System Description: 25% GRAVITY ☐ Business No. Employees

Nitrification Field: No Fields Square Feet 800 Linear Feet 200 Maintenance Agreement Required: ☐ Yes ☐ No ☐ Other


No Lines 3 Trench Width 36" Max Trench Bottom Depth 24" Gravel Depth NA ☐ Slab ☐ Crawl Space ☐ Basement w/plumbing ☐ Basement wo/plumbing

Water Supply: ☐ Individual ☒ Public ☐ Community


Comments:/Conditions: Install on Contour Maintain setback

Comments:/Conditions: Red Polylok system 24" max Trench Depth

INITIAL SITE SKETCH

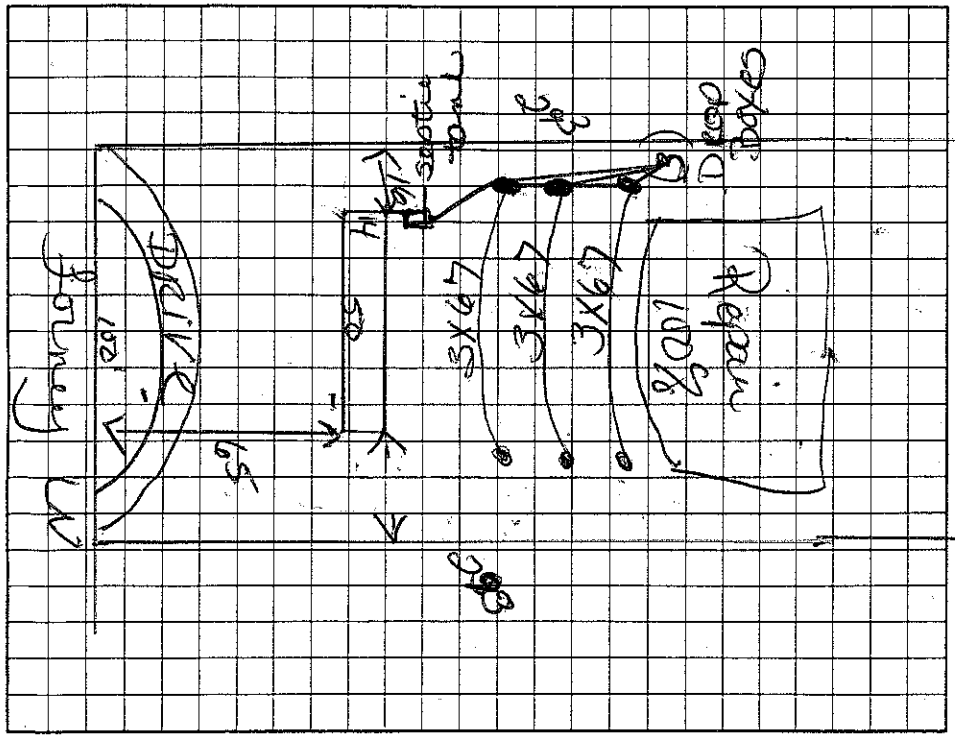

AS BUILT SKETCH

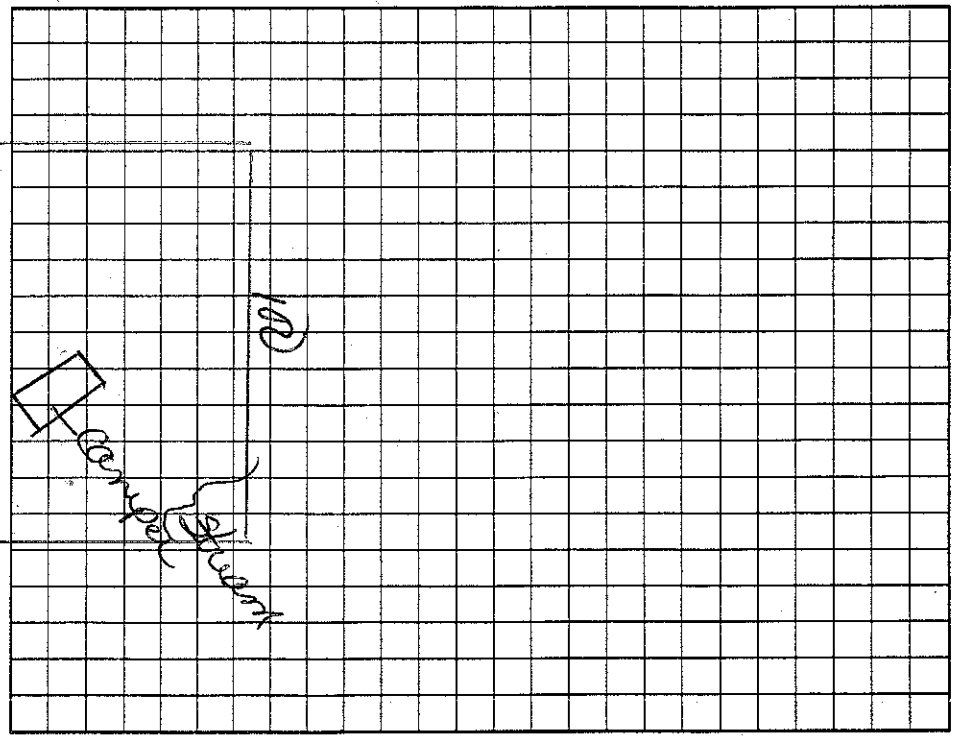

Permit can be suspended or revoked if any false information is supplied toward securing the permit/any unauthorized changes are made to the site/any unauthorized changes are made in the installation of the system. Improvement Permit with plat valid without expiration. Improvement Permit with site plan valid for sixty months. Authorization to Construct is valid for a period equal to that of Improvement Permit – not to exceed sixty months.

Signed: Talmage F. Blackwelder date 8-24-05 Installed by: Trent Callihan

Improvement Permit by: [signature] date 8-24-05 Operation Permit by: [signature] date 12-6-05

Authorization to Construct by: [signature] date 8-24-05 Existing System Inspection by: date

HEALTH DEPT. COPY: WHITE OWNER COPY (FINAL): YELLOW OWNER COPY (INITIAL): PINK