IREDELL COUNTY HEALTH DEPARTMENT

Statesville Office (704) 878-5305 | Mooresville Office (704) 660-3625 | PERMIT # AP-300752

SEPTIC IMPROVEMENT PERMIT / AUTHORIZATION TO CONSTRUCT / OPERATION PERMIT / EXISTING SYSTEM

PIN # 4860750574

APPLICANT/OWNER: CLAYTON HOMES/Charmia Glover | APPLICANT ADDRESS: 2026 NORTHSIDE DRIVE, STATESVILLE, NC 28625

SITE ADDRESS: 157 FORNEY DRIVE, OLIN, NC 28660 | PHONE: 704-929-1552 | ALT. PHONE 704-873-2547

SITE DIRECTIONS: (N) ON 77, (R) ON 901, (R) ON TABOR, (L) ON FORNEY, LOT ON (L) | SAP CONTROLLED: ☐ YES ☐ NO EXT


SUBDIVISION: FORNEY ACRES | SECTION — | LOT # 11 | LOT AREA: 0.91 AC | DESIGN FLOW: EXT | L.T.A.R.: EXT

Septic Tank	EXT (1000) (gal)	STB	EXT	Date	EXT	☑ New System	☐ Repair	☐ Expansion	System Type: I II (III) IV V VI
Pump Tank	— (gal)	PT	—	Date	—	System Description:	EXT		
Pump Make	—	Model	—	Serial #	—	Repair System Description:	EXT		
# Nitrification Fields	EXT	# Lines	EXT	Linear Ft	EXT	Maintenance Agreement Required:	☐ YES	☑ NO	
Trench Width	EXT	Trench Bottom Depth(Low side)	EXT	Gravel Depth	EXT	☑ GRAVITY	☐ PRESSURE		

☑ Residence	No. Bedrooms	EXT	Water Supply
☐ Business	No. Persons	EXT	☑ Private
☐ Other	No. Employees	—	☐ Public
☐ Slab	☑ Crawl Space		☐ Community
☐ Basement w/plumbing	☐ Basement w/o plumbing		

Comments / Conditions: THE PURPOSE OF THIS PERMIT WAS TO REPLACE AN OLD MOBILE HOME WITH A NEW MOBILE HOME. SYSTEM WAS FUNCTIONING AT TIME OF INSPECTION.

INITIAL SITE SKETCH

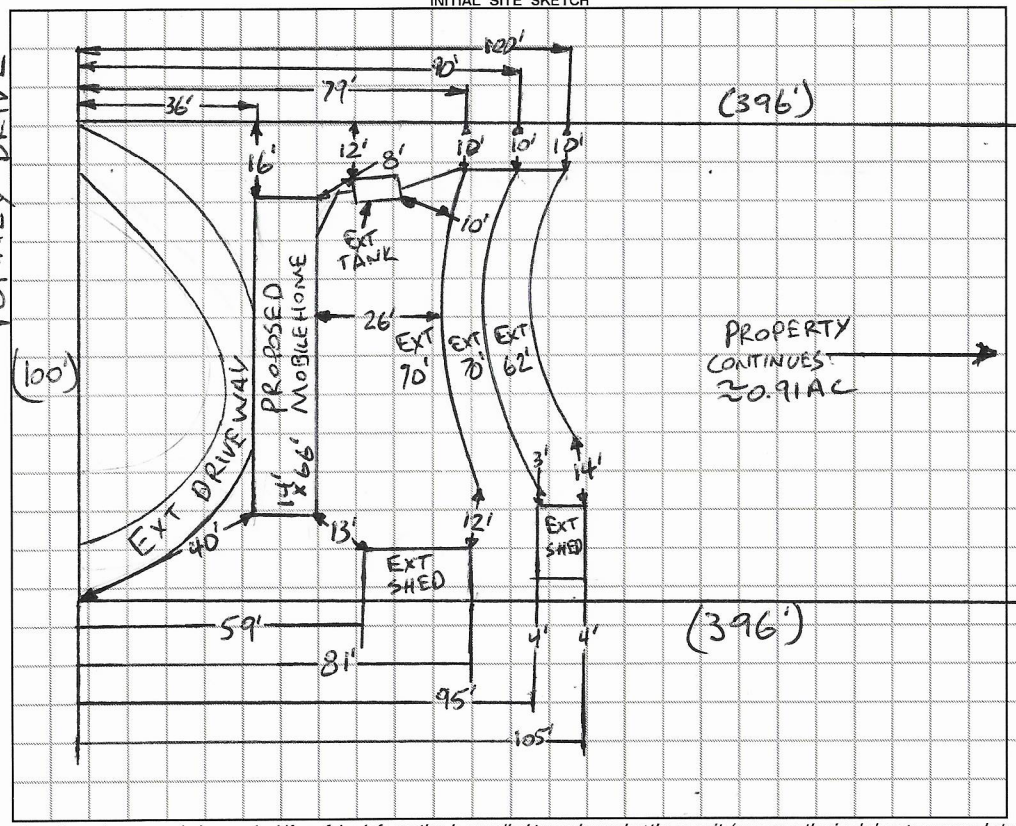

AS BUILT SKETCH

1 IN = 40 FT
EXT = EXISTING

(100')

Permit can be suspended or revoked if any false information is supplied toward securing the permit / any unauthorized changes are made to the site / any unauthorized changes are made in the installation of the system. **CONTACT A LOCATOR SERVICE PRIOR TO ANY EXCAVATION**

☐ **IMPROVEMENT PERMIT** *with plat valid without expiration.* ☑ **IMPROVEMENT PERMIT** *with site plan valid for 60 mos.* ☑ **AUTHORIZATION TO CONSTRUCT** *valid for period equal to IMPROVEMENT PERMIT--not to exceed 60 mo.*

Owner / Applicant Signature: Talmeda E. Blount | Date: 9-27-19 | Installed by: _____

IMPROVEMENT PERMIT by: _____ | Date: _____ | OPERATION PERMIT by: _____ | Date: _____

AUTHORIZATION TO CONSTRUCT by: _____ | Date: _____ | Existing System Inspected by: Burford C. Wilder | Date: 9-26-2019

FOR SEPTIC FINAL INSPECTION: CALL 704-664-3703 between 8am-9am the day the inspection is needed. Be sure to speak with an inpsector to confirm your inspection time.

AP300752

APPLICATION MUST BE FILLED OUT COMPLETELY & BE LEGIBLE OR IT WILL NOT BE PROCESSED

Iredell County Health Department – Environmental Health Division

$250

PAGE 1: *APPLICATION FORM*

Application For:
( ) New Well Permit ( ) Well Repair Permit ( ) Well Abandonment
( ) Septic Improvement Permit ( ) Authorization to Construct (X) Existing System Inspection ( ) Septic System Repair

THE ABOVE PERMIT DOCUMENTS WILL BECOME INVALID IF INFORMATION PROVIDED ON THIS APPLICATION IS FALSIFIED OR CHANGED, OR IF THE SITE IS ALTERED. THE IMPROVEMENT PERMIT IS VALID FOR EITHER 60 MONTHS OR WITHOUT EXPIRATION DEPENDING UPON DOCUMENTATION SUBMITTED. APPLICATION WITH SITE PLAN 60 MONTHS, APPLICATION WITH COMPLETE, SCALED PLAT WITHOUT EXPIRATION. SEE 15A NCAC 18A .1937(f) FOR DETAILS.

Page 2: *Site Plan Worksheet* form MUST accompany this application

The following optional attachments may also be submitted:
Place an (X) beside whichever is submitted if applicable
( ) Survey Plat, scaled no more than 1 inch = 60 feet
( ) Custom Site Plan, scaled no more than 1 inch = 60 feet

Applicant Information: (PRINT CLEARLY)

Applicant Name: CLAYTON HOMES STATESVILLE Address: 2026 NORTHSIDE DR STATESVILLE Zip: _____
Applicant Email: adam.casstevens@claytonhomes.com Phone: 704 873 2547 Alt. Phone: 704 929 1552
Owner Name: CHARNIE GLOVER Address: 157 FORNEY DR OLN Zip: 28660
Owner Email: _____ Phone: _____ Alt. Phone: _____

Property Information:

Street Address: 157 FORNEY DR OLN
Subdivision Name: _____ Section/Phase: _____ Lot Number: _____
Driving Directions: _____

Site Development Information: *(check or complete ALL that apply*

(X) New Single Family Residence
( ) New Multi-Family Residence
( ) Accessory Building
( ) Bedroom(s) Addition
( ) Repair to failing septic system ___ Tank ___ Drain lines Describe Problem: _____

Maximum Number of Bedrooms: 3
Maximum Number of Occupants: 4
( ) Swimming Pool
( ) Other Addition/Structure: _____

CHECK FOUNDATION TYPE
(X) Crawl Space Foundation
( ) Concrete Slab Foundation
( ) Basement with Plumbing
( ) Basement without Plumbing

Non-Residential Site Development: Type of Business: _____
Square Footage of Building: _____ Max. Number of Employees: _____ Max. Number of Seats/Beds/Other: _____

Water Supply: ( ) Replacement Well – Reason: _____
( ) Multi-connection Well Number of Houses: _____ Number of Persons: _____
( ) New Well (X) Existing Well ( ) Community Well ( ) City Water ( ) Other Public Water

Desired Septic System Type: *(you may rank in order of preference)* Year existing system installed: _____
( ) No Preference ( ) Alternative ( ) Conventional ( ) Innovative ( ) Modified Conventional ( ) Other: _____

Please answer the following to the best of your ability:
( ) Yes (X) No Does the site contain any jurisdictional wetlands?
( ) Yes (X) No Is any non-domestic sewage (i.e. industrial) to be generated?
( ) Yes (X) No Is the site subject to approval by any other public agency?

I have read this application and certify that the information provided herein is true, complete, and correct. Authorized county and state officials are granted right of entry to conduct necessary inspections to determine compliance with applicable laws and rules. I understand that I am solely responsible for the proper identification and labeling of all property lines and corners and making the site accessible so that a complete site evaluation can be performed.

Signature: _____ CLAYTON HOMES STATESVILLE 9/10/19
Property owner or owner's legal representative signature (SIGNATURE REQUIRED) DATE


IREDELL COUNTY DEPARTMENT of ENVIRONMENTAL HEALTH

SITE PLAN WORKSHEET

SEE THE "SAMPLE SITE PLAN" BELOW. *INCOMPLETE SITE PLANS WILL BE RETURNED TO YOU FOR COMPLETION AND MAY RESULT IN A DELAY IN THE ISSUANCE OF YOUR SEPTIC SYSTEM OR WELL PERMIT!!!*

Place an (X) beside each item as you complete the site plan:

( ) Property Line measurements are clearly identified
( ) All proposed structures are indicated
( ) Front and side setbacks from property line
( ) Preferred driveway location
( ) Preferred well location
( ) Preferred septic system location
( ) North arrow, or other sufficient indicator of direction

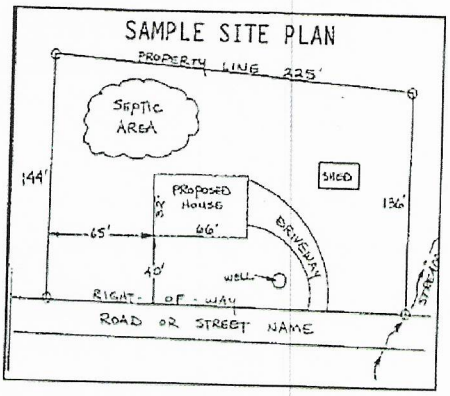

Circle N/A on the following if appropriate:

Location of septic systems and wells within 100' of your property	N/A
Location of easements and rights of ways on your property	N/A
Location of any designated wetlands on the property	N/A


USE THIS SPACE TO DRAW YOUR SITE PLAN

Show: proposed house or business footprint, wells, water lines, patios, pools and decks, and any other item that will occupy space on the site

SEE ATTACHED

Signature: [signature] CLAYTON HOMES STATESVILLE 9/10/19

Property owner or owner's legal representative signature (SIGNATURE REQUIRED) DATE

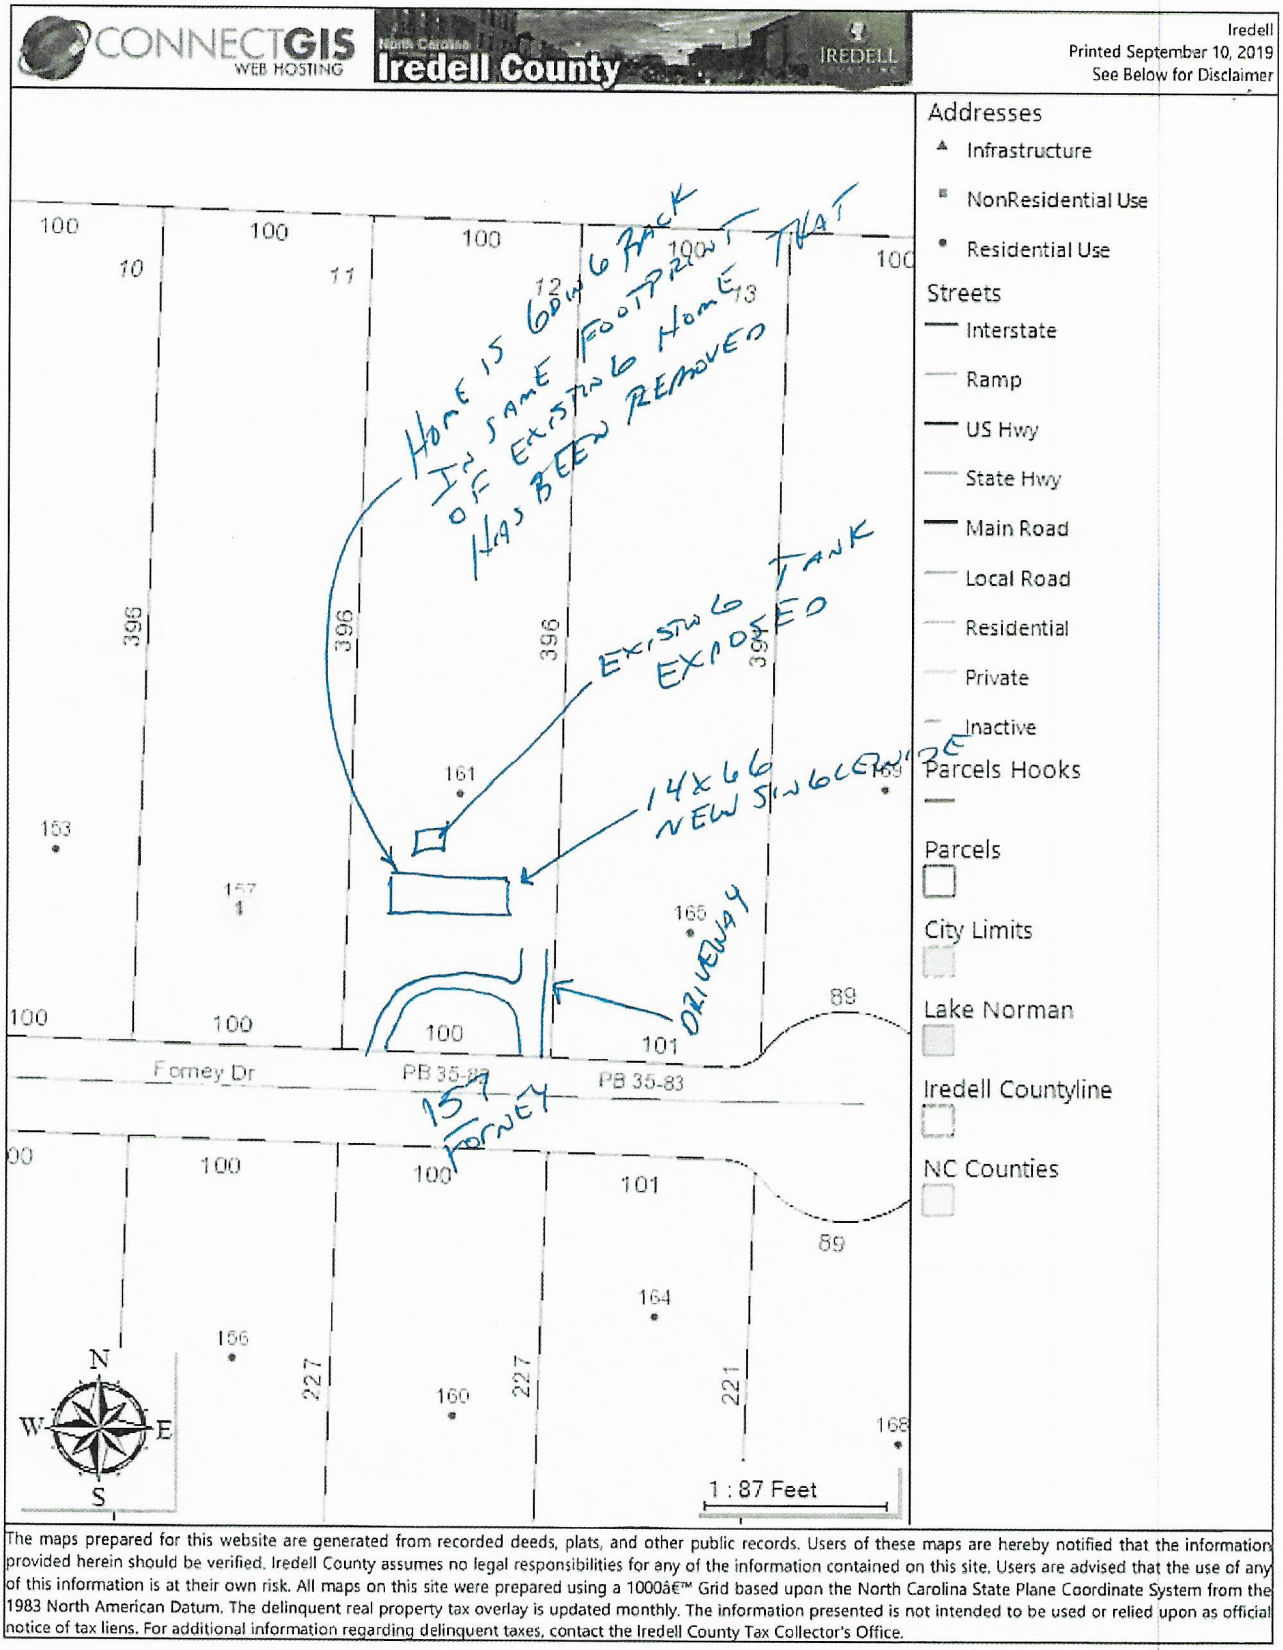

The maps prepared for this website are generated from recorded deeds, plats, and other public records. Users of these maps are hereby notified that the information provided herein should be verified. Iredell County assumes no legal responsibilities for any of the information contained on this site. Users are advised that the use of any of this information is at their own risk. All maps on this site were prepared using a 1000â€™ Grid based upon the North Carolina State Plane Coordinate System from the 1983 North American Datum. The delinquent real property tax overlay is updated monthly. The information presented is not intended to be used or relied upon as official notice of tax liens. For additional information regarding delinquent taxes, contact the Iredell County Tax Collector's Office.

IREDELL COUNTY
PO Box 788
349 North Center St.
Statesville, NC 28677

APPLICATION NUMBER
300752
Issue Date: 09/10/2019

IREDELL COUNTY DEPARTMENT OF ENVIRONMENTAL HEALTH

DOCUMENTATION TO AUTHORIZE AN OWNER'S LEGAL REPRESENTATIVE

(Check and sign only ONE of the options below)

1. * APPLICANT AND OWNER ARE THE SAME. * (*Sign here*) _____

Applications for permits require the "signature of the owner or owner's legal representative" (15A NCAC 18A .1937). If the owner does not sign the application himself or herself, they can submit any one of the following documents to designate their legal representative: *Power of Attorney; Real Estate Contract; Estate executor; Bankruptcy trustee; Court ordered guardianship* In the absence of the above documentation, the property owner may provide the local health department with documentation that designates a legal representative. A property owner may:
Complete this form to document his or her legal representative, or provide his or her own form that contains the information in this form. If there are multiple property owners, then all property owners must sign the form that designates a legal representative.
By signing a form that designates a legal representative for purposes of 15A NCAC 18A .1937, the property owner authorizes that representative to act on their behalf in matters pertaining to the application and permitting process, including signing or receiving any application, document or permit. The owner retains full responsibility to meet all permit conditions specified by the local health department.

2. I, Charmie M Glover am the legal owner(s) of the property located at 157 Forney Dr Olin NC 28660, identified as

PIN (Parcel Identification Number)_____, located in Iredell County, North Carolina.

I do hereby authorize (**print legal representative/company name**) Clayton Homes, Statesville/Adam Castleberry, to act as an agent on my behalf in applying for/signing/obtaining any of the documents described below.

- Application for Improvement Permit (IP) / Authorization to Construct (AC)
- Improvement Permit (IP) / Authorization to Construct (AC)
- Application for soil-site evaluation (new/repair)
- Application/permit for private drinking water well/well abandonment
- Application for Compliance Inspection

I agree to abide by all decisions and/or conditions between the legal representative acting on my behalf and the Iredell County Department of Public Health, Environmental Health Division.

Charmie M Glover
Signature of Owner(s)

9-11-19
Date

Mooresville - Environmental Health
ronda.hart@co.iredell.nc.us
Fax: 704-662-3239
610 E. Center Avenue, Mooresville, NC 28115

Statesville - Environmental Health
adrienne.shea@co.iredell.nc.us
Fax: 704-871-3483
349 N. Center Street, Statesville, NC 28677

→ 157 FORNEY DR OLIN.

Exhibit A
8-22-19

Acknowledgement Of
Plans Submittal ONLY!


_____ Date_____

9/18/19 Date_____

The Linq

Bryant C White 9-27-2019 Display model

Serial # CWP039525TN

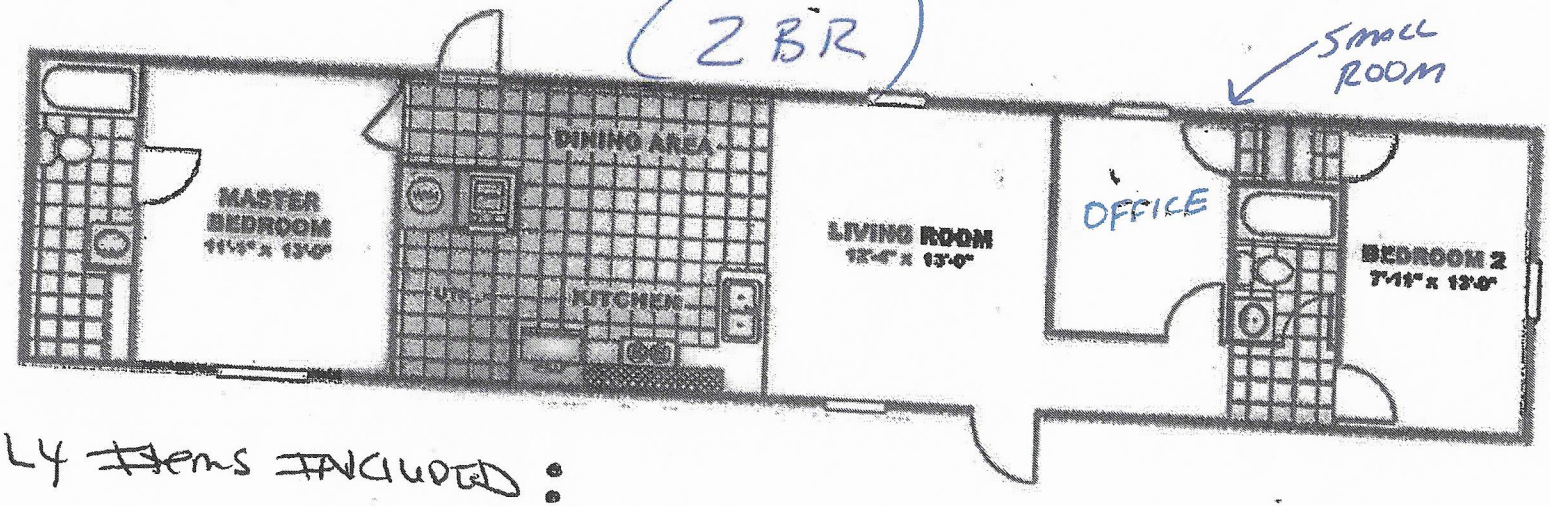

ONLY ~~Items~~ INCLUDED:

- Taxes on home
- Delivery without special equipment
- CASH closing
- Set-up home
- title fees

Channi M Lee

IREDELL COUNTY
PO Box 788
349 North Center St.
Statesville, NC 28677

APPLICATION NUMBER
300752
Issue Date: 09/10/2019

Permit Type: ZONING RESIDENTIAL

Parcel Number	Street Address	Jurisdiction
4860750574.000	157 FORNEY DR	

Owner Information	Applicant Information
Name: GLOVER CHARMIE M	Name: CLAYTON HOMES OF STATESVILLE
Address: 157 FORNEY DR	Address: 2026 NORTHSIDE DR
OLIN, NC 28660	STATESVILLE, NC 28677
Phone:	Phone:

Use Requested	Zone Code
	RA

Lot Acreage	F Setback	B Setback	L Setback	R Setback	Watershed	Flood Zone
0.91	35	35	15	15		

Remarks

Accessory Mobile Home: Must meet requirement R8 of the LDC. Only one accessory mobile shall be permitted per lot or parcel. The lot or parcel shall contain sufficient land area for the principal residential structure or home and the accessory mobile home to be considered independent principal dwelling units with both individually meeting the minimum lot size and required setbacks. The mobile home cannot be used as a rental and only relatives including in-laws and son or daughter by legal adoption shall occupy the accessory mobile home.


The applicant certifies that there are no deed restrictions, contractual agreements or governmental regulations of any kind that interfere with or prohibit the use of the property or the use for which this permit is requested. The applicant further acknowledges that enforcement of deed restrictions, plat conditions and other contractual agreements will not be undertaken by Iredell County and is the sole responsibility of the affected parties.

Signature of Owner/Contractor

Date: 09/10/2019

Permit Number	000226	TOTAL FEES:	$77.25

ZONING DISCLAIMER

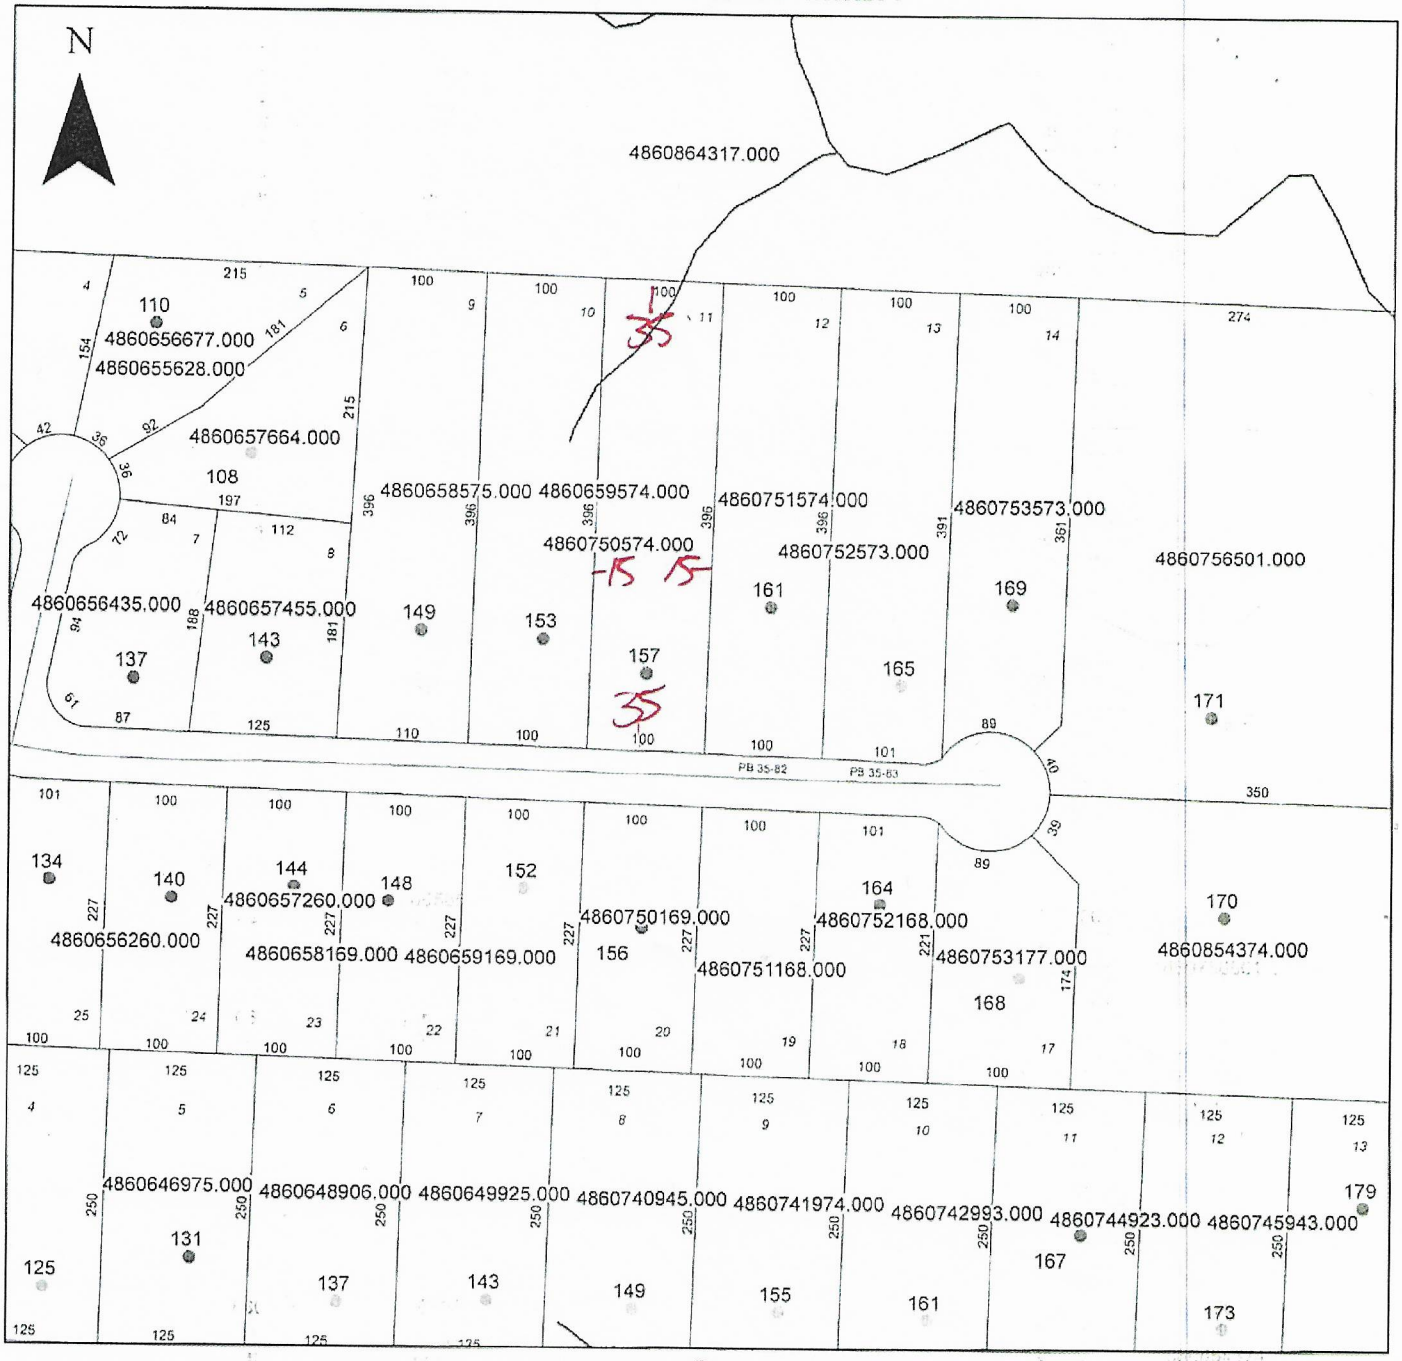

Property Address 157 Forney Dr

The applicant certifies that there are no deed restrictions, contractual agreements or governmental regulations of any kind that interfere with or prohibit the use of the property or the use for which this permit is requested. Applicant further acknowledges that the enforcement of deed restrictions, plat conditions, and other contractual agreements will not be undertaken by Iredell County and is the sole responsibility of the affected parties.

CLOYTON J-S Holmes

Applicant

9/10/19

Date