IREDELL COUNTY HEALTH DEPARTMENT

STATESVILLE 704-878-5305 MOORESVILLE 704-664-5281

IMPROVEMENT PERMIT / AUTHORIZATION TO CONSTRUCT / OPERATION PERMIT / EXISTING SYSTEM INSPECTION

DATE 2/8/01

PERMIT# 094051 PIN# 4760 75 1574

OWNER OR CONTRACTOR JAMES G STARBUCK PHONE: Business Home (704) 873-2547

ADDRESS P.O. BOX 241, STATESVILLE, NC 28687

LOCATION HWY 21 N, (L) TABOR RD., (R) FORNEY RD NEAR END ON (L)

SUBDIVISION FORNEY ACRES BLOCK / SECTION LOT 12 LOT AREA .91 SITE CLASS PS DESIGN FLOW 360 GPD L.T.A.R. .35

Septic Tank: 1000 Gallons: STB 312 Date 1-13-01
Pump Tank: Gallons: PT Date
Pump Make: Model Serial No.
Nitrification Field: No Fields 1 Square Feet 1028 Linear Feet 342'
No Lines 4 Trench Width 3' Max Trench Bottom Depth 24"

☑ New System ☐ Repair System Type: I. (II) III. IV. V. VI
System Description: CONVENTIONAL
Repair System Description: SAME
Maintenance Agreement Required: ☐ Yes ☑ No
Gravel Depth 12" ☐ Slab ☑ Crawl Space ☐ Basement w/plumbing ☐ Basement wo/plumbing


☐ House/Mod. Home No. Bedrooms 3
☑ Mobile Home No. Bathrooms 2
☐ Business No. Employees
☐ Other

Water Supply: ☐ Individual ☑ Public ☐ Community

Comments/Conditions: ① NO CUTTING OR FILLING OVER DRAINFIELD/REPAIR AREA ② KEEP ALL DRAINS AWAY FROM DRAINFIELD/REPAIR AREA ③ MAINTAIN ALL SETBACKS ④ INSTALL DRAINLINES UNIFORM AND ON CONTOUR.

Comments/Conditions: SEPTIC TANK WITH RISERS INSTALLED USING "FLOW-LOK" FILTER

INITIAL SITE SKETCH

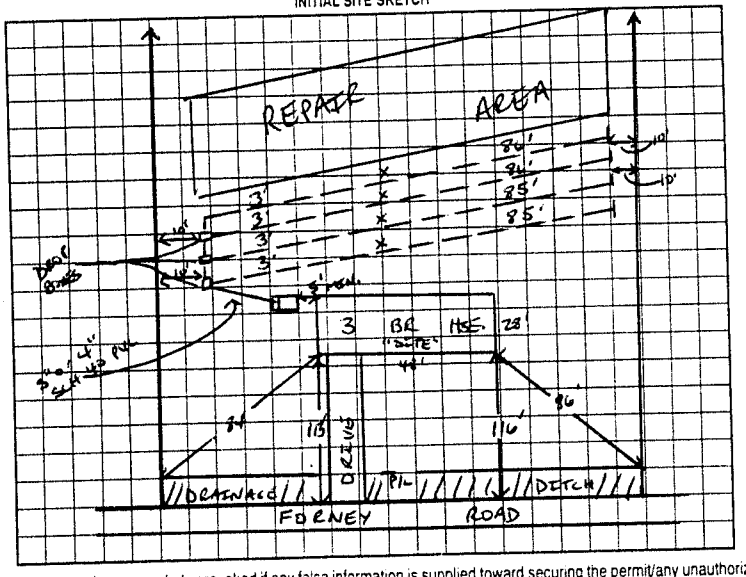

AS BUILT SKETCH

SYSTEM INSTALLED ACCORDING TO INITIAL SITE SKETCH

Permit can be suspended or revoked if any false information is supplied toward securing the permit/any unauthorized changes are made to the site/any unauthorized changes are made in the installation of the system. Improvement Permit with plat valid without expiration. Improvement Permit with site plan valid for sixty months. Authorization to Construct is valid for a period equal to that of Improvement Permit – not to exceed sixty months.

Signed: Wendy Starbuck date 2-9-01

Improvement Permit by: [signature] date 2/9/01

Authorization to Construct by: [signature] date 2/9/01

Installed by: KENNY MADISON

Operation Permit by: STEVE HEDRICK date 3-9-01

Existing System Inspection by: date

HEALTH DEPT. COPY WHITE OWNER COPY (FINAL) YELLOW OWNER COPY (INITIAL) PINK