IREDELL COUNTY HEALTH DEPARTMENT

STATESVILLE 704-878-5305 MOORESVILLE 704-664-5281

IMPROVEMENT PERMIT / AUTHORIZATION TO CONSTRUCT / OPERATION PERMIT / EXISTING SYSTEM INSPECTION

PERMIT # 15427 PIN # 4860 75 1574 DATE 1-8-09

OWNER or APPLICANT David Snow PHONE: Business Home:

OWNER or APPLICANT ADDRESS 788 Kinder Rd Harmony 28634

LOCATION / DIRECTIONS Lovelace Mill (I) Gabon (R) Barney Site on left

SUBDIVISION Barney Acres BLOCK / SECTION LOT # 12 LOT AREA .9 PAC DESIGN FLOW 360 L.T.A.R. .35 (Exist)

Septic Tank 1000 Gallons: STB 312-BMP Date 1-13-01-Exist ☐ New System ☐ Repair ☐ Expansion System Type (II) III IV V VI

Pump Tank Gallons: P T Date System Description: Conventional

Pump Make Model Serial # Repair System Description: 25% C

Nitrification Field No Fields No Lines Linear Feet 342 Maintenance Agreement Required ☐ YES ☐ NO

Trench Width 4 Max. Trench Bottom Depth 24 Gravel Depth 12 ☐ GRAVITY ☐ PRESSURE

☒ Residence No. Bedrooms 3 ☐ Business No. Persons 2 ☐ Other No. Employees ☐ Slab ☐ Crawl Space ☐ Basement w/plumbing ☐ Basement w/o plumbing


Water Supply ☐ Private ☒ Public ☐ Community

Comments / Conditions


Comments / Conditions

Trailer is (2) Bedroom
System is (3) Bedroom

INITIAL SITE SKETCH

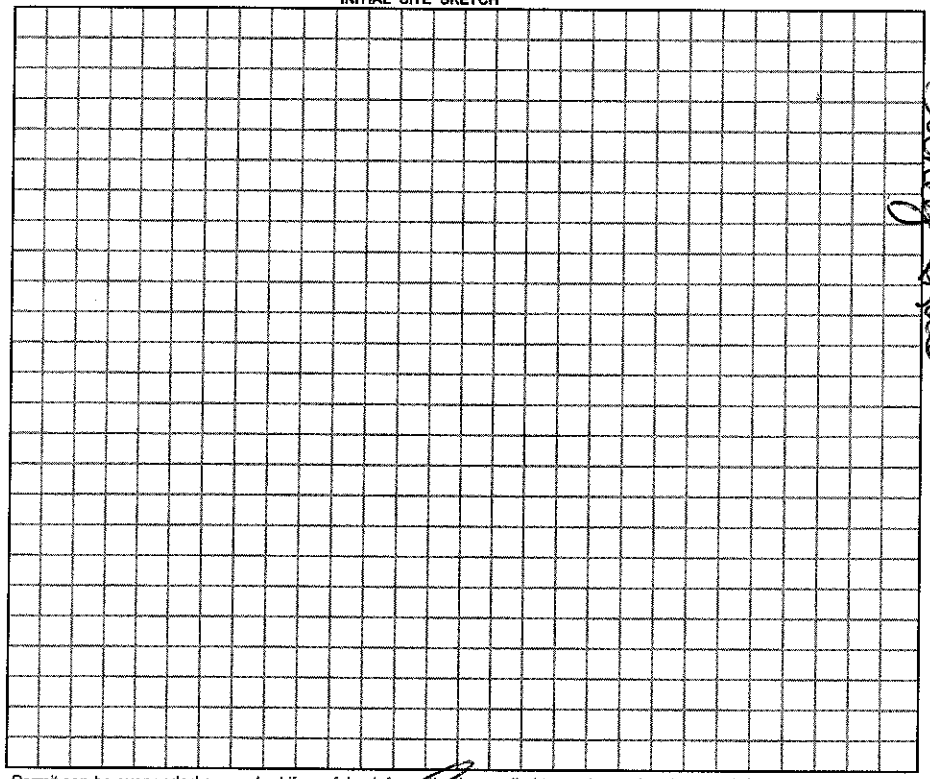

AS BUILT SKETCH

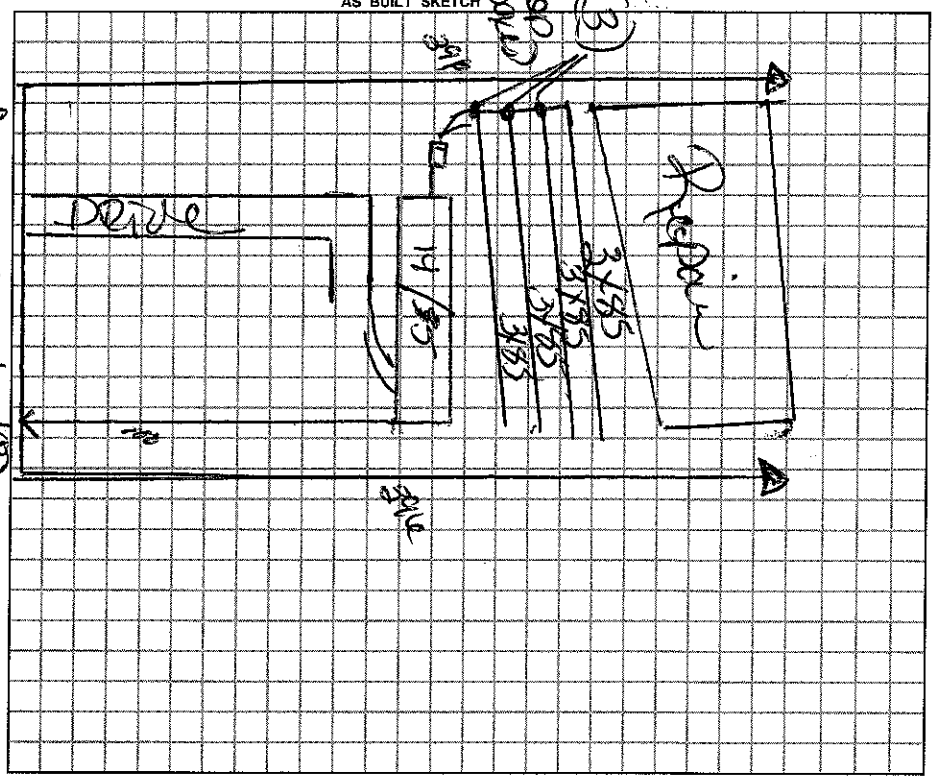

Permit can be suspended or revoked if any false information is supplied toward securing the permit / any unauthorized changes are made to the site / any unauthorized changes are made in the installation of the system.

☐ *IMPROVEMENT PERMIT w / plat valid without expiration.* ☐ *IMPROVEMENT PERMIT w / site plan valid for 60 mos.* ☒ *AUTHORIZATION TO CONSTRUCT valid for period equal to IMPROVEMENT PERMIT-not to exceed 60 mo.*

Owner / Applicant Signature: Date 1-12-09

Improvement Permit by: Date

Authorzation to Construct by: Date

YOU SHOULD CONTACT A LOCATOR SERVICE PRIOR TO ANY EXCAVATION.

Installed by:

Operation Permit by: Date:

Existing System Inspected by: Date: 1-8-09

WHITE COPY Environmental Health YELLOW COPY (Final) Owner / Applicant PINK COPY (Initial) Owner / Applicant