IREDELL COUNTY HEALTH DEPARTMENT

STATESVILLE 704-878-5305 MOORESVILLE 704-664-5281

IMPROVEMENT PERMIT / AUTHORIZATION TO CONSTRUCT / OPERATION PERMIT / EXISTING SYSTEM INSPECTION

PERMIT# 092666 PIN# 4860 74 2322 DATE 10-27-00

OWNER OR CONTRACTOR MONIQUE CLARK PHONE: Business Home 871-0890

ADDRESS 1940 GAY STREET, STATESVILLE, NC 28625

LOCATION US 21 N, TL TABOR ROAD, TR FORNEY ROAD, AT END BEFORE CUL-DE-SAC ON RIGHT

SUBDIVISION FORNEY ACRES BLOCK / SECTION LOT 18 LOT AREA 0.52 ACRE SITE CLASS PS DESIGN FLOW 360 L.T.A.R. 0.30 GPD/FT²

Septic Tank: 1000 Gallons: STB 1012 Date 8-26-00
Pump Tank: Gallons: PT Date
Pump Make: Model Serial No.
Nitrification Field: No Fields 1 Square Feet 1200 Linear Feet 400
No Lines FIVE Trench Width 36" Max Trench Bottom Depth 36" Gravel Depth 12"

☑ New System ☐ Repair System Type: ☐ I ☐ II ☐ III ☐ IV ☐ V ☐ VI
System Description: CONVENTIONAL GRAVITY
Repair System Description: 25% REDUCTION PUMP
Maintenance Agreement Required: ☐ Yes ☑ No
☐ Slab ☑ Crawl Space ☐ Basement w/plumbing ☐ Basement wo/plumbing

☐ House/Mod. Home ☑ Mobile Home ☐ Business ☐ Other
No. Bedrooms 3 No. Bathrooms 2 No. Employees


Water Supply: ☐ Individual ☑ Public ☐ Community

Comments/Conditions: CONTACT HEALTH DEPARTMENT AFTER CLEARING AND PRIOR TO INSTALLATION TO FLAG-OUT SYSTEM

Comments/Conditions: SEPTIC TANK WITH RISERS INSTALLED USING "POLYLOK" FILTER

CUL-DE-SAC

INITIAL SITE SKETCH SCALE: 1"=40'

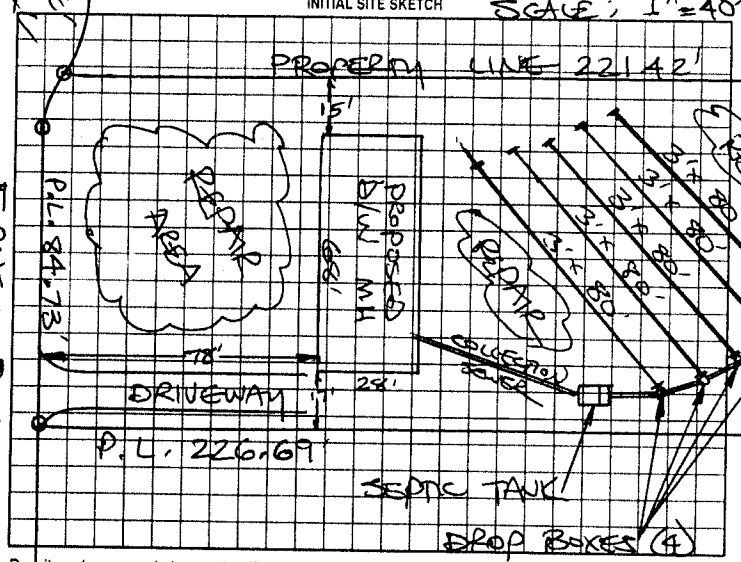

AS BUILT SKETCH

SYSTEM INSTALLED ACCORDING TO INITIAL SITE SKETCH

FORNEY ROAD

Permit can be suspended or revoked if any false information is supplied toward securing the permit/any unauthorized changes are made to the site/any unauthorized changes are made in the installation of the system. Improvement Permit with plat valid without expiration. Improvement Permit with site plan valid for sixty months. Authorization to Construct is valid for a period equal to that of Improvement Permit – not to exceed sixty months.

Signed: x Monique Clark date 10/27/00 Installed by: A-1 BACKHOE

Improvement Permit by: STEVE HEDRICK date 10-27-00 Operation Permit by: STEVE HEDRICK date 11-3-00

Authorization to Construct by: STEVE HEDRICK date 10-27-00 Existing System Inspection by: date

HEALTH DEPT COPY: WHITE OWNER COPY (FINAL): YELLOW OWNER COPY (INITIAL): PINK