IREDELL COUNTY HEALTH DEPARTMENT

STATESVILLE 704-878-5305 MOORESVILLE 704-664-5281

IMPROVEMENT PERMIT / AUTHORIZATION TO CONSTRUCT / OPERATION PERMIT / EXISTING SYSTEM INSPECTION

PERMIT# 122304 PIN# 4860-75-2168 DATE 6-28-04

OWNER OR CONTRACTOR FLEETWOOD HOMES OF STATESVILLE PHONE: Business (704) 872-0179 Home

ADDRESS 1270 NORTHSIDE DR. STATESVILLE NC 28677

LOCATION 21 N (L) TABOR (R) FORNEY LOT AT END ON RIGHT OF CUL-DE-SAC

SUBDIVISION FORNEY ACRES BLOCK / SECTION LOT 18 LOT AREA .52 SITE CLASS. PS DESIGN FLOW 360 L.T.A.R. EXISTING

Septic Tank: 1000 EX. Gallons; STB Date

Pump Tank: Gallons; PT Date

Pump Make: Model Serial No.

Nitrification Field: No Fields 1 Square Feet 1200 Linear Feet 400 EX.

No Lines 5 Trench Width 36" Max Trench Bottom Depth 36" Gravel Depth 12"

☐ New System ☐ Repair System Type: I, (II) III, IV, V, VI

System Description: CONVENTIONAL GRAVITY

Repair System Description: 25% REDUCTION, PUMP

Maintenance Agreement Required: ☐ Yes ☑ No

☐ House/Mod. Home ☑ Mobile Home ☐ Business ☐ Other

No. Bedrooms 3 No. Bathrooms 4 No. Employees


☐ Slab ☑ Crawl Space ☐ Basement w/plumbing ☐ Basement wo/plumbing

Water Supply: ☐ Individual ☑ Public ☐ Community IREDELL WATER


Comments:/Conditions:

Comments:/Conditions: (1) SYSTEM FUNCTIONING PROPERLY AT TIME OF INSPECTION (2) PERMISSION TO CONNECT NEW STRUCTURE TO EXISTING SYSTEM (3) NEW STRUCTURE SHALL NOT INCREASE NO. OF BEDROOMS ON SYSTEM (4) INSPECTION IS VISUAL ONLY AND NO GUARANTEE PROBLEMS WON'T ARISE IN FUTURE.

INITIAL SITE SKETCH

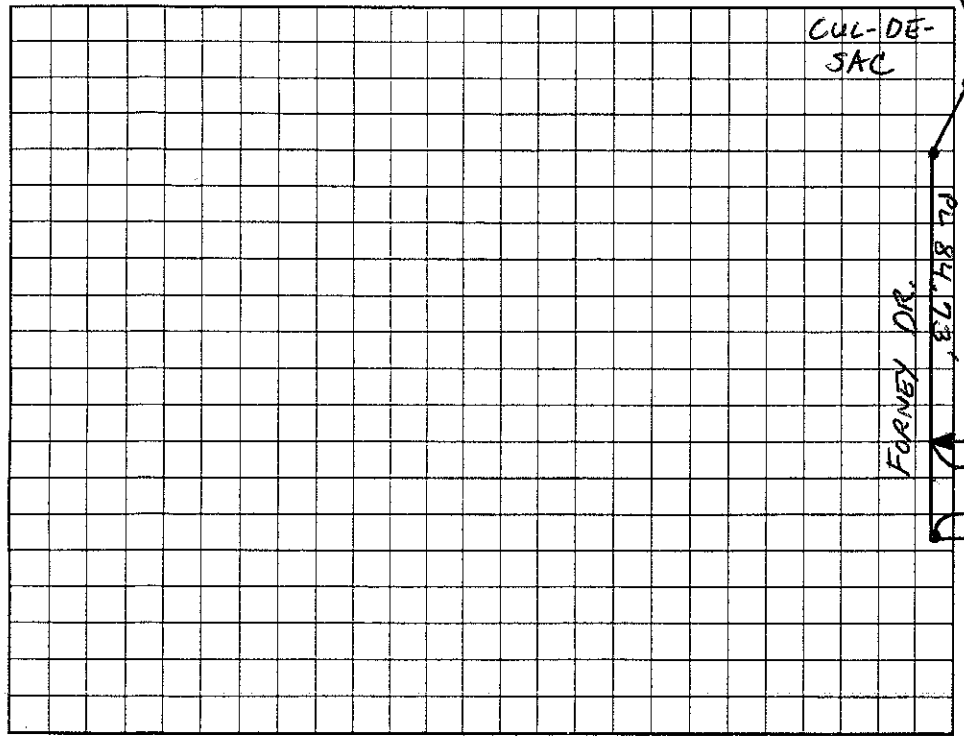

AS BUILT SKETCH *NOT TO SCALE

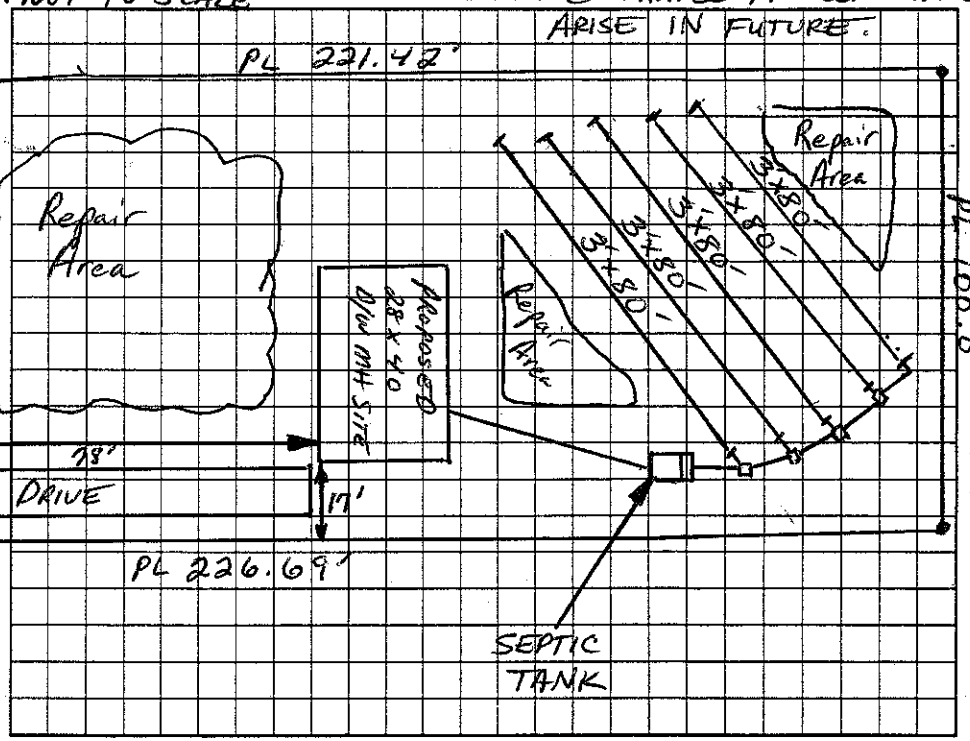

Permit can be suspended or revoked if any false information is supplied toward securing the permit/any unauthorized changes are made to the site/any unauthorized changes are made in the installation of the system. Improvement Permit with plat valid without expiration. Improvement Permit with site plan valid for sixty months. Authorization to Construct is valid for a period equal to that of Improvement Permit – not to exceed sixty months.

Signed: [signature] date 6/28/04 Installed by: A-1 BACKHOE

Improvement Permit by: date Operation Permit by: date

Authorization to Construct by: date Existing System Inspection by: [signature], RS date 6-28-04

HEALTH DEPT. COPY: WHITE OWNER COPY (FINAL): YELLOW OWNER COPY (INITIAL): PINK