IREDELL COUNTY HEALTH DEPARTMENT

STATESVILLE 704-878-5305 MOORESVILLE 704-664-5281

IMPROVEMENT PERMIT / AUTHORIZATION TO CONSTRUCT / OPERATION PERMIT / EXISTING SYSTEM INSPECTION

PERMIT# 092124 PIN# 4860 74 2322 (PT) DATE 10-23-00

OWNER OR CONTRACTOR DANIELLE REEVES PHONE: Business Home 872-7646

ADDRESS 508 NORTH GREENBRIAR ROAD, STATESVILLE NC 28625

LOCATION US 21 N, TL TABOR ROAD, TR FORNEY DRIVE, LOT AT END ON LEFT

SUBDIVISION FORNEY ACRES BLOCK / SECTION LOT 15 LOT AREA 3.29 ACRES SITE CLASS PS DESIGN FLOW 480 L.T.A.R. 0.30 GPD/FT²

Septic Tank: 1000 Gallons; STB 312 Date 5-26-00
Pump Tank: Gallons; PT Date
Pump Make: Model Serial No.
Nitrification Field: No Fields 1 Square Feet 1600 Linear Feet 540
No Lines SIX Trench Width 36" Max Trench Bottom Depth 30" Gravel Depth 12"

☑ New System ☐ Repair System Type: I II III IV V VI
System Description: CONVENTIONAL GRAVITY
Repair System Description: CONV. GRAVITY
Maintenance Agreement Required: ☐ Yes ☑ No

☑ House/Mod. Home No. Bedrooms 4
☐ Mobile Home No. Bathrooms 3
☐ Business No. Employees
☐ Other


☐ Slab ☑ Crawl Space ☐ Basement w/plumbing ☐ Basement wo/plumbing

Water Supply: ☐ Individual ☑ Public ☐ Community

Comments/Conditions:


SCALE: 1" = 50'

INITIAL SITE SKETCH

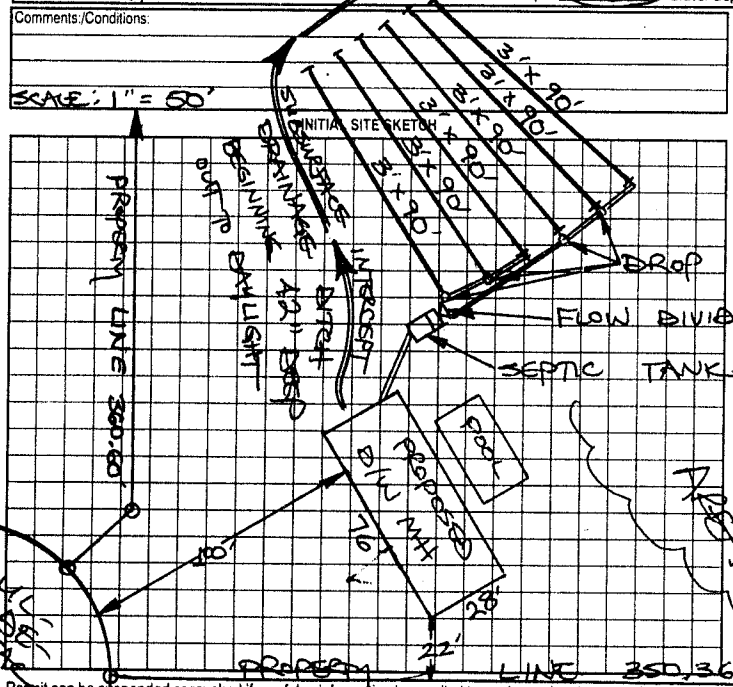

Comments/Conditions ① CONTACT H. DEPT. AFTER CLEARING AND PRIOR TO INSTALLATION TO FLAG-OUT SYSTEM
② INSTALL SUBSURFACE INTERCEPT DRAINAGE DITCH AS SHOWN BEGINNING 42" DEEP OUT TO DAYLIGHT

AS BUILT SKETCH

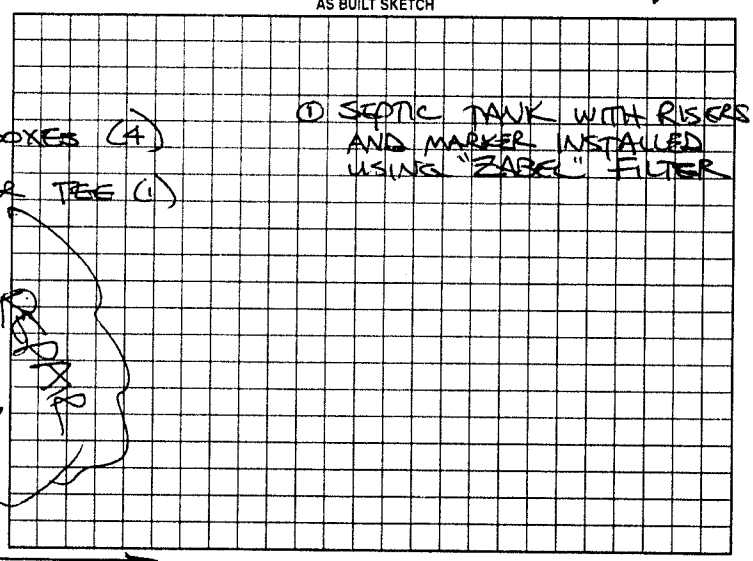

Permit can be suspended or revoked if any false information is supplied toward securing the permit/any unauthorized changes are made to the site/any unauthorized changes are made in the installation of the system. Improvement Permit with plat valid without expiration. Improvement Permit with site plan valid for sixty months. Authorization to Construct is valid for a period equal to that of Improvement Permit – not to exceed sixty months.

Signed: +Danielle Reeves date 10-23-00 Installed by: Upright Grading

Improvement Permit by: STEVE HEDRICK date 10-23-00 Operation Permit by: [signature] date 11-7-00

Authorization to Construct by: STEVE HEDRICK date 10-23-00 Existing System Inspection by: date

HEALTH DEPT. COPY: WHITE OWNER COPY (FINAL) YELLOW OWNER COPY (INITIAL) PINK