330 · 400

IREDELL COUNTY HEALTH DEPARTMENT

STATESVILLE 704-878-5305 MOORESVILLE 704-664-5281

IMPROVEMENT PERMIT / AUTHORIZATION TO CONSTRUCT / OPERATION PERMIT / EXISTING SYSTEM INSPECTION

PERMIT# 91498 PIN# 486 0840 942 DATE 9/13/00

OWNER OR CONTRACTOR Arthur Hayes PHONE: Business Home 873-4282

ADDRESS 242 Chestnut Grove Rd. Statesville NC 28625

LOCATION 21N, L Tabor, R Ashford, Near end on Lt.

SUBDIVISION Holly Ridge BLOCK / SECTION 2 LOT 16 LOT AREA .87 SITE CLASS PS DESIGN FLOW 360 L.T.A.R. 0.3

Septic Tank: 1000 Gallons; STB 1012 Date 9/5/00

Pump Tank: Gallons; PT Date

Pump Make: Model Serial No.

Nitrification Field: No Fields 1 Square Feet 1200 Linear Feet 400

No Lines 4@100' Trench Width 36" Max Trench Bottom Depth 24" Gravel Depth 12"

[X] New System [ ] Repair System Type: I II III IV V VI

System Description: Gravel Conv.

Repair System Description: Same

Maintenance Agreement Required: [ ] Yes [X] No

[X] House/Mod. Home No. Bedrooms 3

[ ] Mobile Home No. Bathrooms 2

[ ] Business No. Employees

[ ] Other


[ ] Slab [X] Crawl Space [ ] Basement w/plumbing [X] Basement wo/plumbing

Water Supply: [ ] Individual [X] Public [ ] Community


Comments:/Conditions: POLYLOK FILTER INSTALLED

Comments:/Conditions:

INITIAL SITE SKETCH

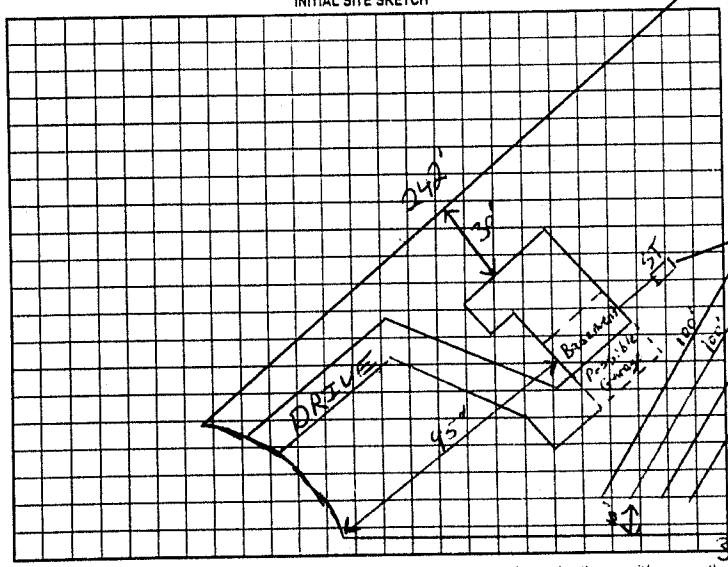

AS BUILT SKETCH

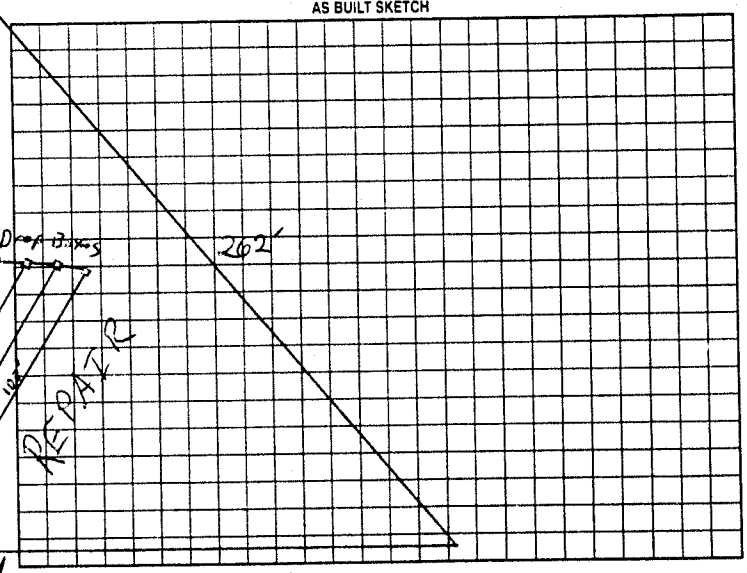

Permit can be suspended or revoked if any false information is supplied toward securing the permit/any unauthorized changes are made to the site/any unauthorized changes are made in the installation of the system. Improvement Permit with plat valid without expiration. Improvement Permit with site plan valid for sixty months. Authorization to Construct is valid for a period equal to that of Improvement Permit – not to exceed sixty months.

Signed: Arthur L Hayes date

Improvement Permit by: RST date 9/15/00

Authorization to Construct by: RST date 9/15/00

Installed by: BRENT CALLIHER

Operation Permit by: RS date 12/28/00

Existing System Inspection by: date

HEALTH DEPT. COPY: WHITE OWNER COPY (FINAL): YELLOW OWNER COPY (INITIAL): PINK