IREDELL COUNTY HEALTH DEPARTMENT

THIS PERMIT VOIDS PERMIT #094053 ISSUED 3-8-01

STATESVILLE 704-878-5305 (el) MOORESVILLE 704-664-5281

IMPROVEMENT PERMIT / AUTHORIZATION TO CONSTRUCT / OPERATION PERMIT / EXISTING SYSTEM INSPECTION

PERMIT# 10749 PIN# ~~4860-84-2257~~ 4860-84-2168 DATE 7-9-02

OWNER OR CONTRACTOR JEFFREY & CECILIA HILLIARD PHONE: Business 704-361-5956 Home 704-720-0736

ADDRESS 4680 FALCON CHASE DR, CONCORD, NC 28027

LOCATION US 21 N TO TABOR ROAD, TO VALLEY SPRINGS DRIVE LOTS 49 & 50 AT END

SUBDIVISION Holly RIDGE BLOCK / SECTION II LOT ~~49~~ & 50 LOT AREA 2.73 AC (TOTAL) SITE CLASS. PS DESIGN FLOW 480 L.T.A.R. 0.25 GPD/FT²

Septic Tank: 1000 Gallons; STB 760 Date 1-4-03
Pump Tank: 1000 Gallons; PT 3603 Date 3-12-03
Pump Make: ZOELLER Model BN-153-A Serial No.
Nitrification Field: No Fields 1 Square Feet Eq, To 1920 Linear Feet 480
No Lines FOUR Trench Width 36" Max Trench Bottom Depth 36"

☒ New System ☐ Repair System Type: I, II, III, IV, V, VI
System Description: 25% REDUCTION, PUMP
Repair System Description: 50% REDUCTION, LOW-PRESSURE
Maintenance Agreement Required: ☐ Yes ☒ No
Gravel Depth N/A


☒ House/Mod. Home ☐ Mobile Home ☐ Business ☐ Other
No. Bedrooms 4 No. Bathrooms 2 No. Employees
☐ Slab ☐ Crawl Space ☒ Basement w/plumbing ☐ Basement wo/plumbing

Water Supply: ☐ Individual ☒ Public ☐ Community


Comments/Conditions: ① KEEP TANKS OUT OF 100 YEAR FLOOD ZONE ② SEE ATTACHED SHEETS FOR PUMP & PRESSURE MANIFOLD REQUIREMENTS.

Comments/Conditions: SEPTIC TANK WITH MARKER INSTALLED USING "POLYLOK" FILTER

INITIAL SITE SKETCH

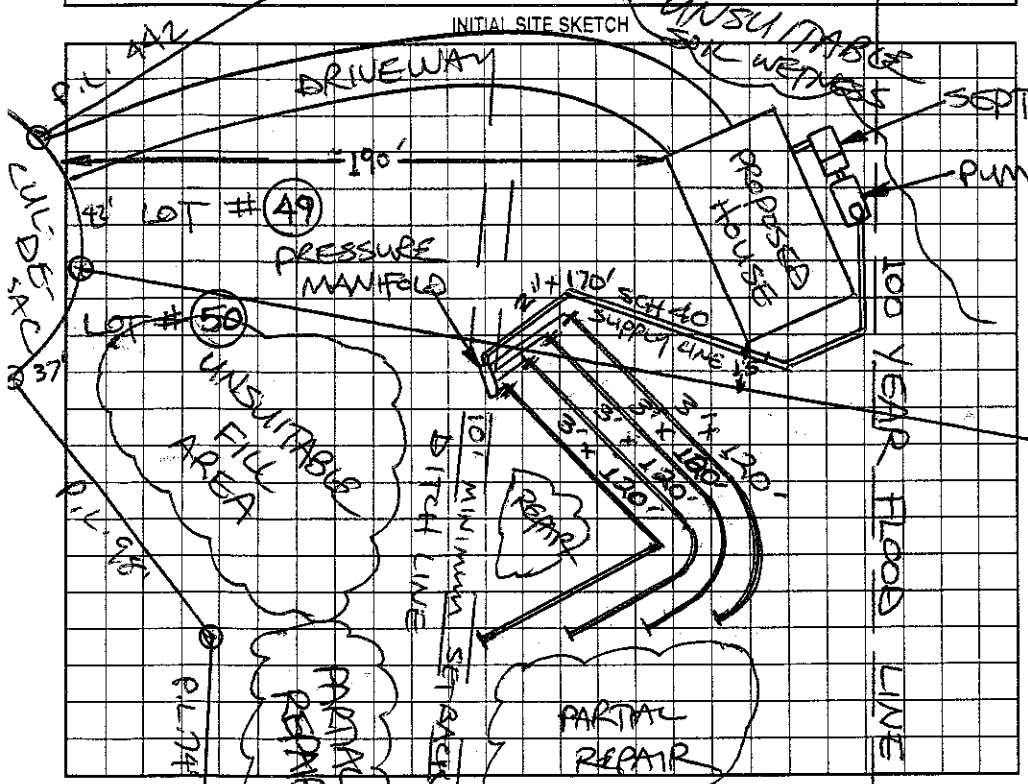

AS BUILT SKETCH

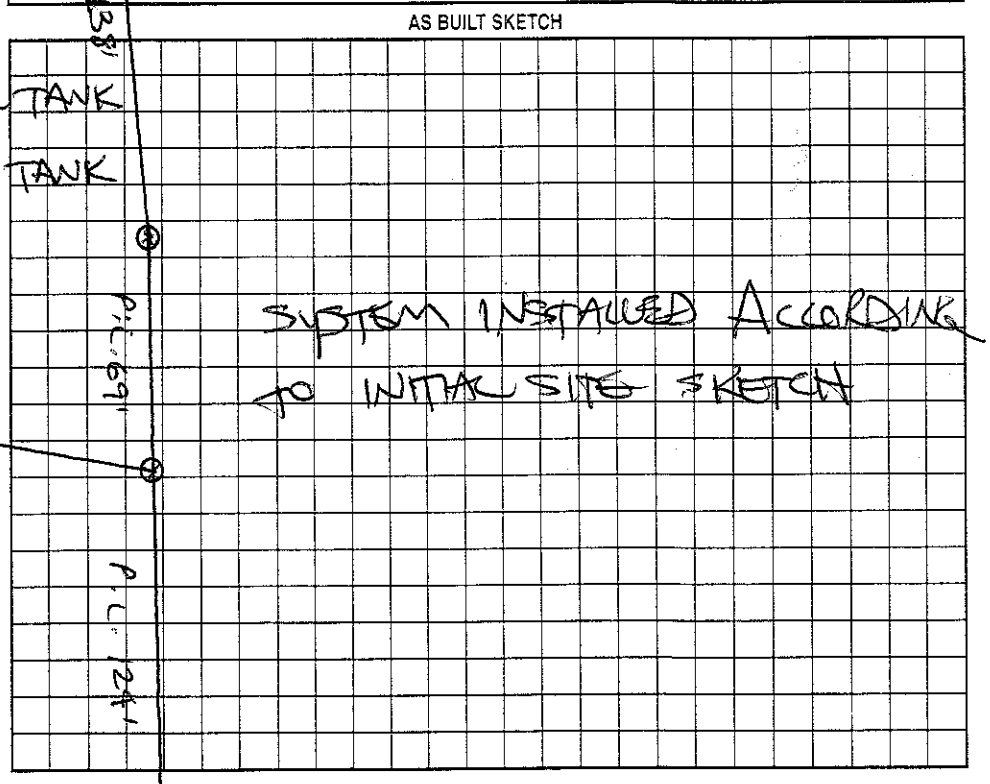

Permit can be suspended or revoked if any false information is supplied toward securing the permit/any unauthorized changes are made to the site/any unauthorized changes are made in the installation of the system. Improvement Permit with plat valid without expiration. Improvement Permit with site plan valid for sixty months. Authorization to Construct is valid for a period equal to that of Improvement Permit – not to exceed sixty months.

Signed: [signature] date 7-23-02 Installed by: BRENT GALLIHER

Improvement Permit by: STEVE HEDRICK date 7-9-02 P.L. 302, 128 Operation Permit by: STEVE HEDRICK date 6-24-03

Authorization to Construct by: STEVE HEDRICK date 7-9-02 Existing System Inspection by: date

HEALTH DEPT. COPY: WHITE OWNER COPY (FINAL): YELLOW OWNER COPY (INITIAL): PINK