IREDELL COUNTY HEALTH DEPARTMENT

STATESVILLE 704-878-5305 MOORESVILLE 704-664-5281

IMPROVEMENT PERMIT / AUTHORIZATION TO CONSTRUCT / OPERATION PERMIT / EXISTING SYSTEM INSPECTION

PERMIT# 90869 PIN# 4860742322PT DATE 10/19/00

OWNER OR CONTRACTOR LAZARUS RAMSEY PHONE: Business Home 528-6924

ADDRESS PO BOX 1043 TROUTMAN NC 28166

LOCATION 21N-TL TABOR-TR FORNEY-AT END IN CUL-DE SAC

SUBDIVISION FORNEY ACRES BLOCK / SECTION LOT 16 LOT AREA 16.99AC SITE CLASS. RS DESIGN FLOW 360 GPD L.T.A.R. .3600/FT²

Septic Tank: 1000 Gallons; STB 760 Date 9-19-00
Pump Tank: Gallons; PT Date
Pump Make: Model Serial No.
Nitrification Field: No Fields 1 Square Feet 1200 Linear Feet 400
No Lines 5@80' Trench Width 36" Max Trench Bottom Depth 36"

☑ New System ☐ Repair System Type: I, II, III, IV, V, VI
System Description: GRAVITY CONVENTIONAL
Repair System Description: SAME
Maintenance Agreement Required: ☐ Yes ☑ No
Gravel Depth 12" ☐ Slab ☑ Crawl Space ☐ Basement w/plumbing ☐ Basement wo/plumbing


☑ House/Mod. Home No. Bedrooms 3
☑ Mobile Home No. Bathrooms 3
☐ Business No. Employees
☐ Other

Water Supply: ☐ Individual ☑ Public ☐ Community

Comments:/Conditions:

Comments:/Conditions: SEPTIC TANK WITH MARKER INSTALLED USING "ZABEL" FILTER

1"=100' INITIAL SITE SKETCH

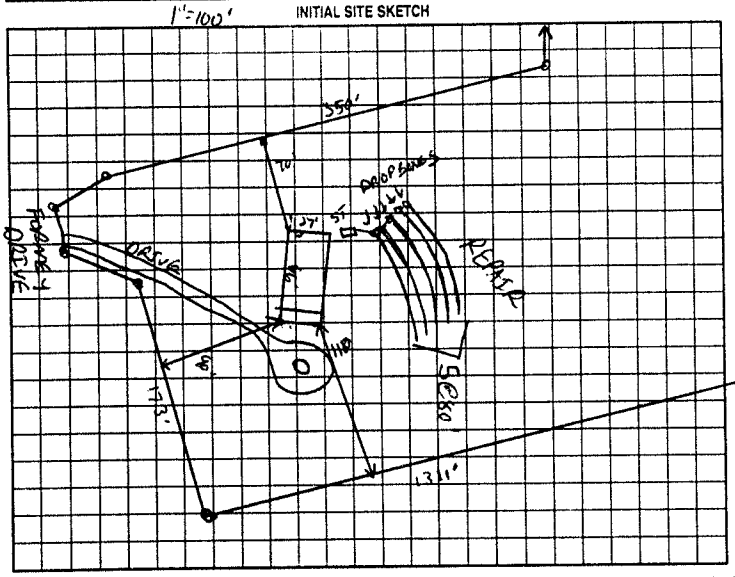

AS BUILT SKETCH

SYSTEM INSTALLED ACCORDING TO INITAL SITE SKETCH

Permit can be suspended or revoked if any false information is supplied toward securing the permit/any unauthorized changes are made to the site/any unauthorized changes are made in the installation of the system. Improvement Permit with plat valid without expiration. Improvement Permit with site plan valid for sixty months. Authorization to Construct is valid for a period equal to that of Improvement Permit – not to exceed sixty months.

Signed: Kay R Ramsey date 10-19-00

Improvement Permit by: [signature] RS date 10/19/00

Authorization to Construct by: [signature] RS date 10/19/00

Installed by: BRENT GALLIHER

Operation Permit by: STEVE HEDRICK date 11-13-00

Existing System Inspection by: date

HEALTH DEPT. COPY: WHITE OWNER COPY (FINAL): YELLOW OWNER COPY (INITIAL): PINK