IREDELL COUNTY HEALTH DEPARTMENT

STATESVILLE 704-878-5305 MOORESVILLE 704-664-5281

IMPROVEMENT PERMIT / CERTIFICATE OF COMPLETION / OPERATION PERMIT / EXISTING SYSTEM INSPECTION

PROPERTY DESCRIPTION NO. 23310 DATE 3-30-96 TAX MAP NO. 12N-6-A-11 Watershed: ☐ Yes ☑ No

OWNER OR CONTRACTOR JOHN R. COX PHONE: Business Home 546-5193

ADDRESS 143 WINDMILL COURT HARMONY NC 28634

LOCATION US 21 N TL TOMLIN, TL Hickory Grove, TR WINDMILL, DN LEFT BEFORE CUL-DE-SAC

SUBDIVISION DUTCHMAN CREEK BLOCK / SECTION LOT 11 LOT AREA AMPLE SITE CLASS PS DESIGN FLOW 360 L.T.A.R. EXISTING 0.9

Septic Tank: 1000 Gallons; STB Date

Pump Tank: Gallons; PT Date

Pump Make: Model Serial No.

Nitrification Field: No Fields | Square Feet 900 Linear Feet 300

No Lines 2 Trench Width Max Trench Bottom Depth Gravel Depth 12"

☐ New System ☐ Repair System Type: I II III IV V VI

System Description: CONV. GRAVITY

Repair System Description:

Maintenance Agreement Required: ☐ Yes ☑ No

☐ Slab ☐ Crawl Space ☐ Basement w/plumbing ☐ Basement wo/plumbing

☐ House/Mod. Home ☑ Mobile Home ☐ Business ☐ Other

No. Bedrooms 3 No. Bathrooms 2 No. Employees


Water Supply: ☐ Individual ☐ Community ☑ Public

Comments:

Comments:
① KEEP MH MINIMUM 5' FROM SYSTEM
② EXISTING S/W MH TO BE REMOVED UPON OCCUPANCY OF D/W MH.

INITIAL SITE SKETCH

AS BUILT SKETCH

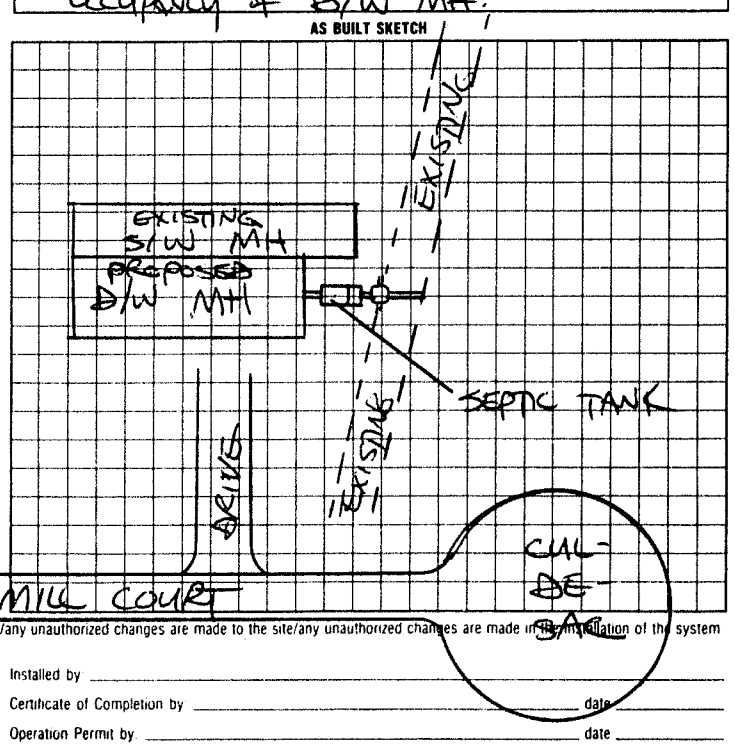

I understand that this permit can be suspended or revoked if any false information is supplied toward securing the permit/any unauthorized changes are made to the site/any unauthorized changes are made in the installation of the system

Signed:

Improvement Permit by: date

Existing System Inspection by: STEVE HERRICK date 3-30-96

Installed by

Certificate of Completion by date

Operation Permit by date

HEALTH DEPT. COPY: WHITE INSPECTION COPY (FINAL) GREEN OWNER COPY (FINAL) YELLOW INSPECTION COPY (INITIAL) PINK OWNER COPY (INITIAL) GOLD