4860931143

IREDELL COUNTY HEALTH DEPARTMENT

STATESVILLE 704-878-5305 MOORESVILLE 704-664-5281

IMPROVEMENT PERMIT / AUTHORIZATION TO CONSTRUCT / OPERATION PERMIT / EXISTING SYSTEM INSPECTION

PERMIT # 154275 PIN # 4860931153 DATE 12-31-09

OWNER or APPLICANT Robert L. Teverpaugh PHONE: Business ______ Home: 704 657-7961

OWNER or APPLICANT ADDRESS 146 Windmill Ct. - HARMONY

LOCATION / DIRECTIONS 146 Windmill Ct. - HARMONY

SUBDIVISION n/a BLOCK / SECTION n/a LOT # n/a LOT AREA .62 DESIGN FLOW 360 L.T.A.R. .25

Septic Tank 1000 Gallons: STB 1012 Date 7-18-12

Pump Tank ______ Gallons: PT ______ Date ______

Pump Make ______ Model ______ Serial # ______

Nitrification Field No Fields 1 No Lines 3 Linear Feet 360 total

Trench Width 36" Max. Trench Bottom Depth 32" Gravel Depth n/a

☒ GRAVITY ☐ PRESSURE

☒ New System ☐ Repair ☐ Expansion System Type I (II) III IV V VI

System Description: 25% Reduction Gravity

Repair System Description: 50% Reduction LP

Maintenance Agreement Required ☐ YES ☒ NO

☒ Residence No. Bedrooms 3

☐ Business No. Persons ______

☐ Other No. Employees ______


☐ Slab ☐ Crawl Space

☒ Basement w/plumbing ☐ Basement w/o plumbing

Water Supply: ☒ Private ☐ Public ☐ Community

Comments / Conditions

INITIAL SITE SKETCH

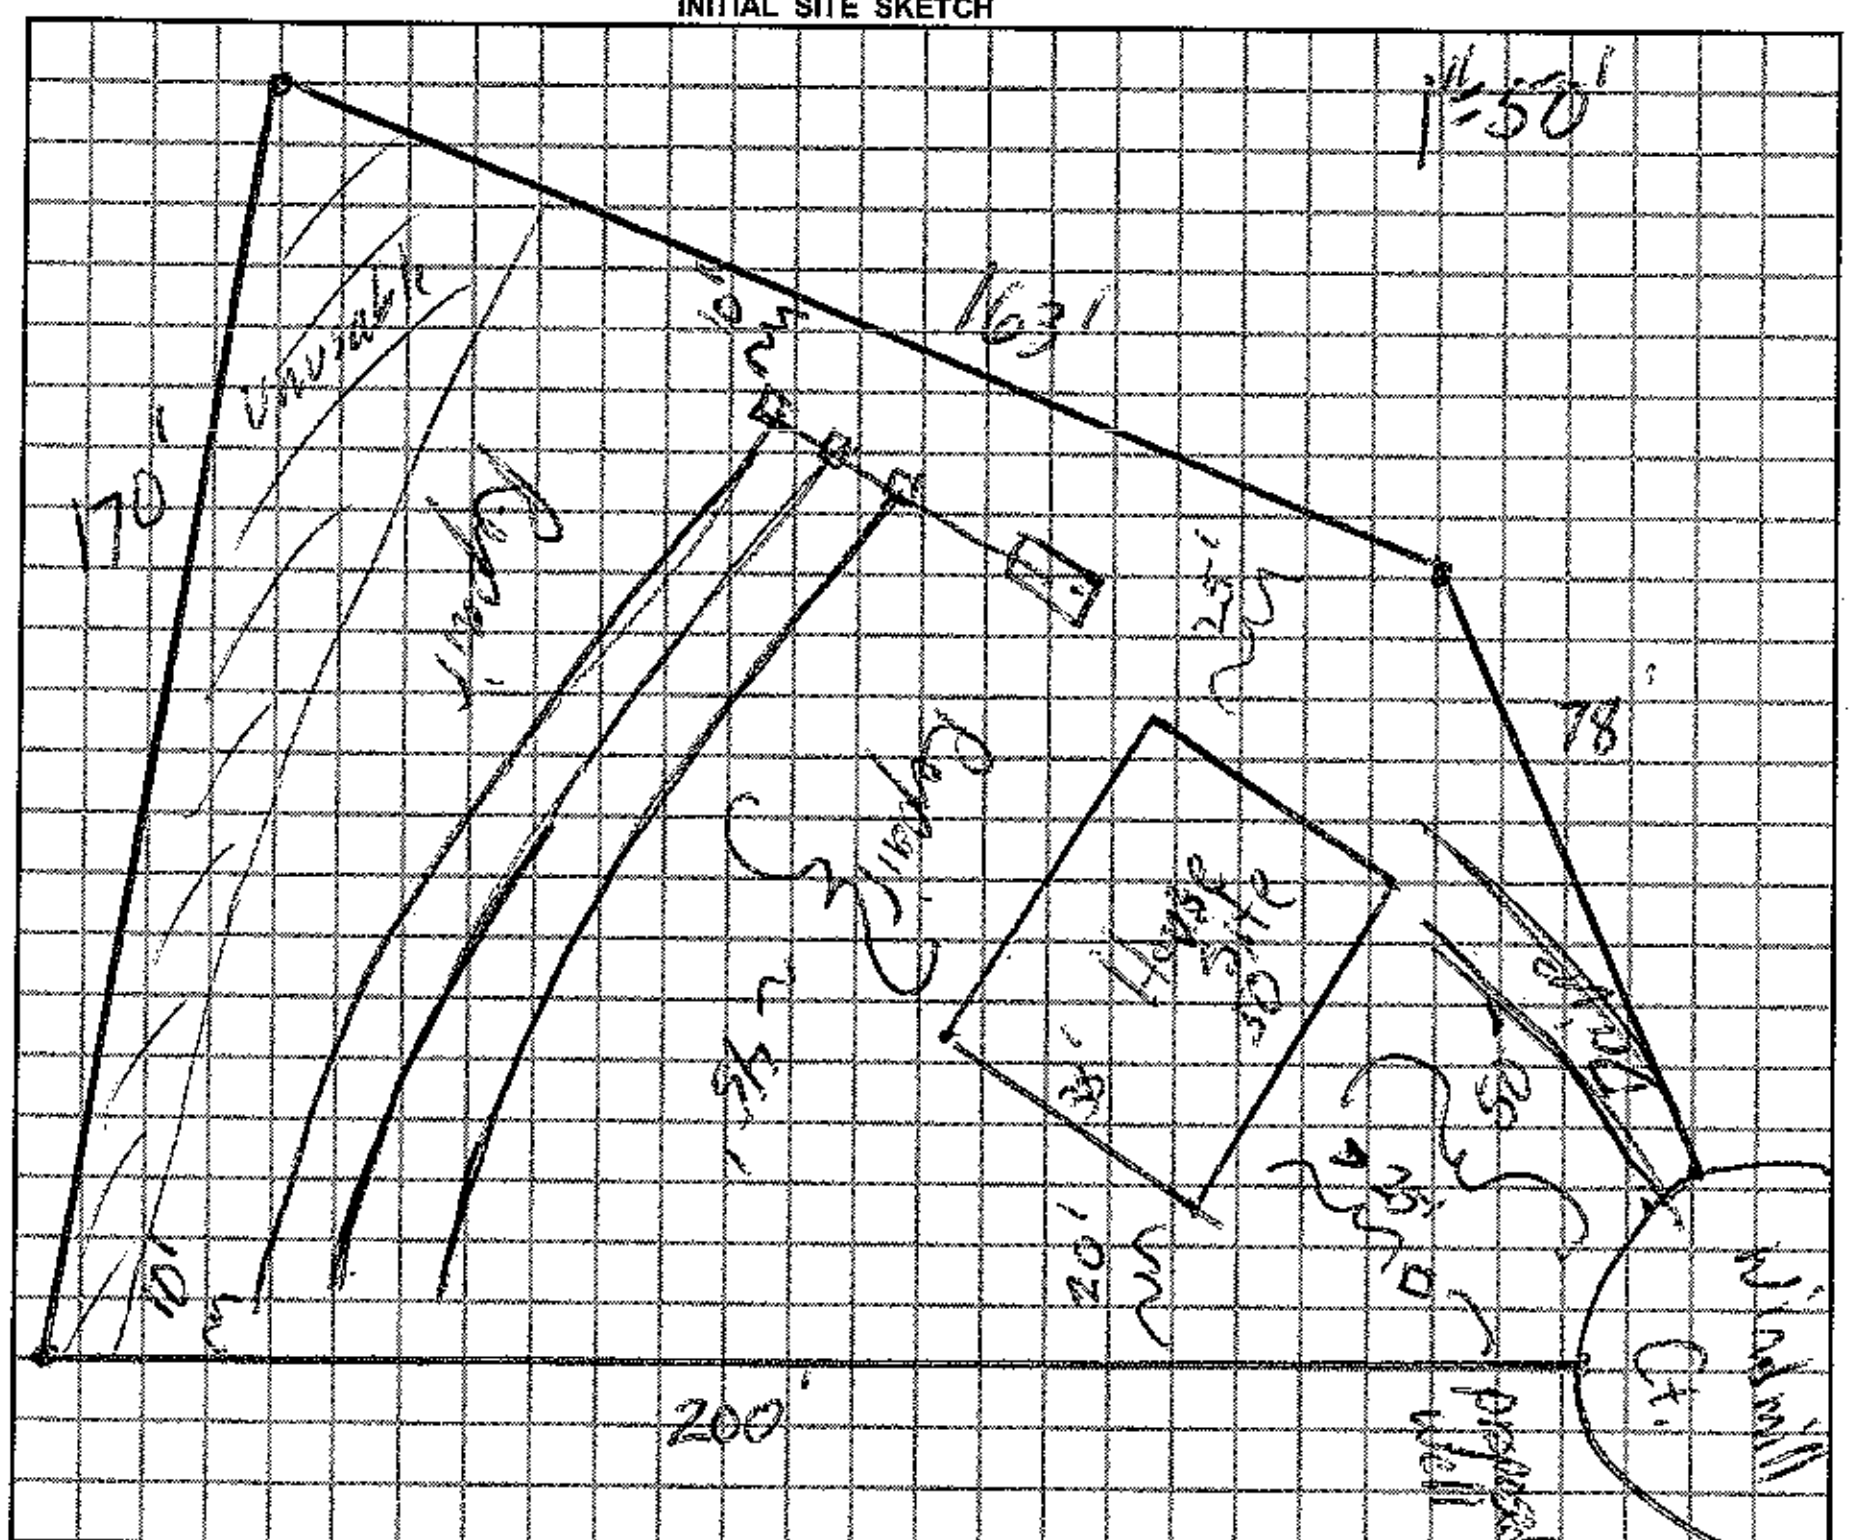

Comments / Conditions

AS BUILT SKETCH

Permit can be suspended or revoked if any false information is supplied toward securing the permit / any unauthorized changes are made to the site / any unauthorized changes are made in the installation of the system.

☐ *IMPROVEMENT PERMIT w / plat valid without expiration.* ☒ *IMPROVEMENT PERMIT w / site plan valid for 60 mos.* ☒ *AUTHORIZATION TO CONSTRUCT valid for period equal to IMPROVEMENT PERMIT-not to exceed 60 mo.*

Owner / Applicant Signature: [signature] Date 1-4-10

Improvement Permit by: [signature] Date 12-31-09

Authorzation to Construct by: [signature] Date 12-31-09

YOU SHOULD CONTACT A LOCATOR SERVICE PRIOR TO ANY EXCAVATION.

Installed by: Tommy Frye

Operation Permit by: [signature] Date: 5-13-13

Existing System Inspected by: ______ Date: ______

WHITE COPY Environmental Health YELLOW COPY (Final) Owner / Applicant PINK COPY (Initial) Owner / Applicant