IREDELL COUNTY HEALTH DEPARTMENT

STATESVILLE 704-878-5305 MOORESVILLE 704-664-5281

IMPROVEMENT PERMIT / CERTIFICATE OF COMPLETION / OPERATION PERMIT / EXISTING SYSTEM INSPECTION

PROPERTY DESCRIPTION NO. 16702 DATE 7/27/93 TAX MAP NO. 16A-A-6B

OWNER OR CONTRACTOR SHERRY STANLEY PHONE: Business Home 539-4140

ADDRESS PO BOX 387 HARMONY, NC 28634

LOCATION US 21 N, TL TABOR RD, TL JERICHO RD, ON (R) ~ 1 MILE

SUBDIVISION BLOCK / SECTION LOT LOT AREA LIMITED SITE CLASS PS L.T.A.R. EX.

Water Supply: ✓ Individual ☐ Community ☐ Public WELL

Septic Tank: EX Gallons; STB Date

Pump Tank: Gallons; PT Date

Nitrification Field: No Fields Square Feet EX Linear Feet EX

No Lines Trench Width Trench Depth Gravel Depth

☐ New System ☐ Repair System Type: (I) II, V, VI

System Description: CONV. GRAVITY

Repair System Description:

Maintenance Agreement Required: ☐ Yes ☐ No

✓ House/Mod. Home ✓ Mobile Home ☐ Business ☐ Other

No. Bedrooms 2 No. Bathrooms 1 No. Employees

Garbage Disposal: ☐ Yes ☐ No

Auto. Dishwasher: ☐ Yes ☐ No

Auto. Washing Machine: ☐ Yes ☐ No


Other

Slab ✓ Crawl Space Basement w/plumbing ☐ Basement wo/plumbing


Comments (1) REPLACING 2BR S/W WITH 2BR S/W

(2) KEEP MH MINIMUM 5' FROM SEPTIC SYSTEM

SITE SKETCH

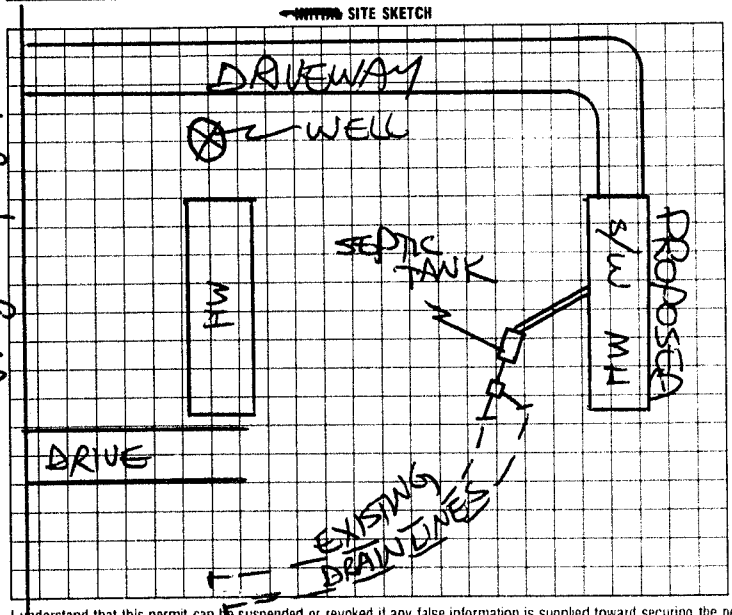

AS BUILT SKETCH

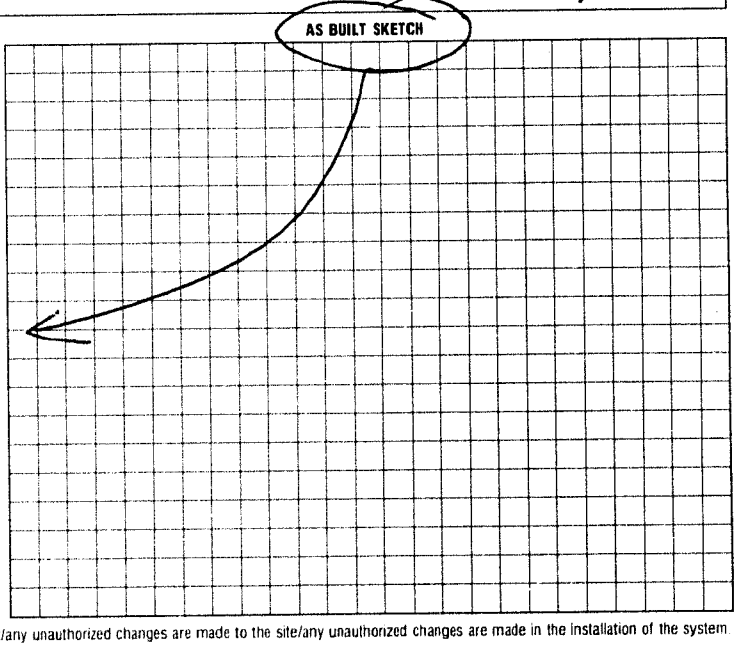

I understand that this permit can be suspended or revoked if any false information is supplied toward securing the permit/any unauthorized changes are made to the site/any unauthonzed changes are made in the installation of the system. Improvement Permit is valid for 60 months from date of issuance.

Signed:

Improvement Permit by: date

Existing System Inspection by: STEVE HEDRICK date 7-27-93

Installed by

Certificate of Completion by: date

Operation Permit by: date

HEALTH DEPT. COPY: WHITE INSPECTION COPY (FINAL): GREEN OWNER COPY (FINAL): YELLOW INSPECTION COPY (INITIAL): PINK OWNER COPY (INITIAL): GOLD