IREDELL COUNTY HEALTH DEPARTMENT

STATESVILLE 704-878-5305 MOORESVILLE 704-664-5281

IMPROVEMENT PERMIT / CERTIFICATE OF COMPLETION / OPERATION PERMIT / EXISTING SYSTEM INSPECTION

PROPERTY DESCRIPTION NO 23279 DATE 3-19-96 TAX MAP NO 16A-1-A-16 Watershed: Yes (No)

OWNER OR CONTRACTOR WALLACE S. BUTLER PHONE: Business Home 539-5389

ADDRESS 113 RUNNING CEDAR LANE HAMPTONVILLE, NC 27020

LOCATION US 21 N, TL TABOR ROAD, TL SPEAKS ROAD TR HAYSTACK LANE, ON LEFT AT CUL-DE-SAC

SUBDIVISION Holly Bob FARMS BLOCK / SECTION LOT 16 LOT AREA 5.37 ACRES SITE CLASS PS DESIGN FLOW 360 LTAR 0.30 GPD/FT2

Septic Tank 1000 Gallons; STB 1012 Date 3-1-96

Pump Tank Gallons; PT Date

Pump Make Model Serial No

Nitrification Field No Fields 1 Square Feet 1200 Linear Feet 400

No Lines 4 Trench Width 36" Max Trench Bottom Depth 18-36" Gravel Depth 12"

New System Repair System Type: I (II) III IV V VI

System Description: CONVENTIONAL GRAVITY

Repair System Description CONVENTIONAL GRAVITY

Maintenance Agreement Required Yes No

House/Mod Home No Bedrooms 3

Mobile Home No Bathrooms 2

Business No Employees

Other


Slab Crawl Space Basement w/plumbing Basement wo/plumbing

Water Supply: Individual, Community, Public


Comments ① USE THREE FLOW DIVIDER TEES TO ACHIEVE EQUAL DISTRIBUTION INTO EACH OF FOUR 100' LINES ② INSTALL LINES ON CONTOUR NO DEEPER THAN 36", 9' APART MINIMUM ON CENTERS

Comments:

INITIAL SITE SKETCH

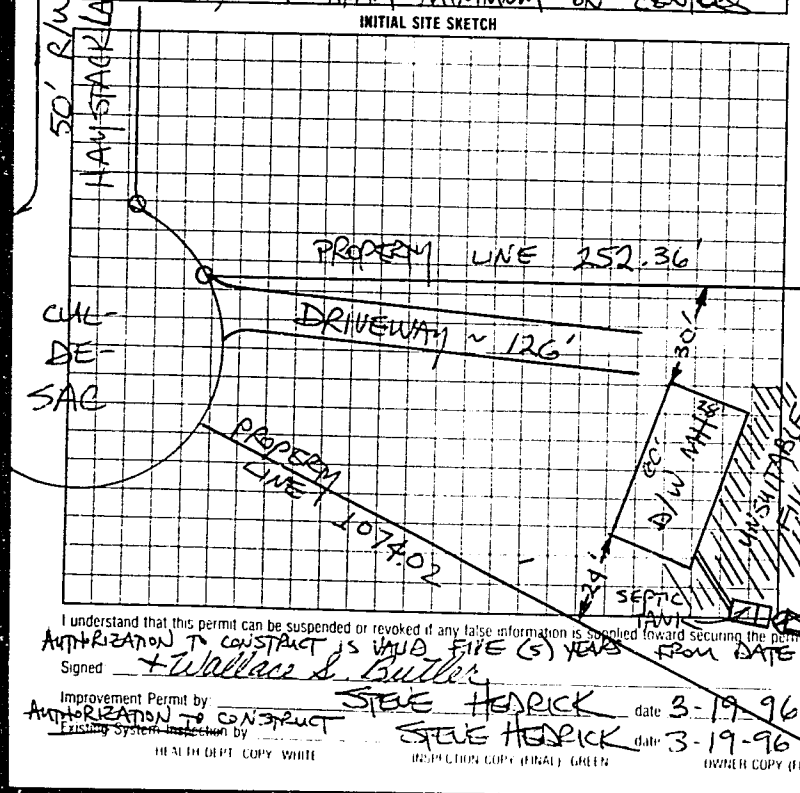

AS BUILT SKETCH

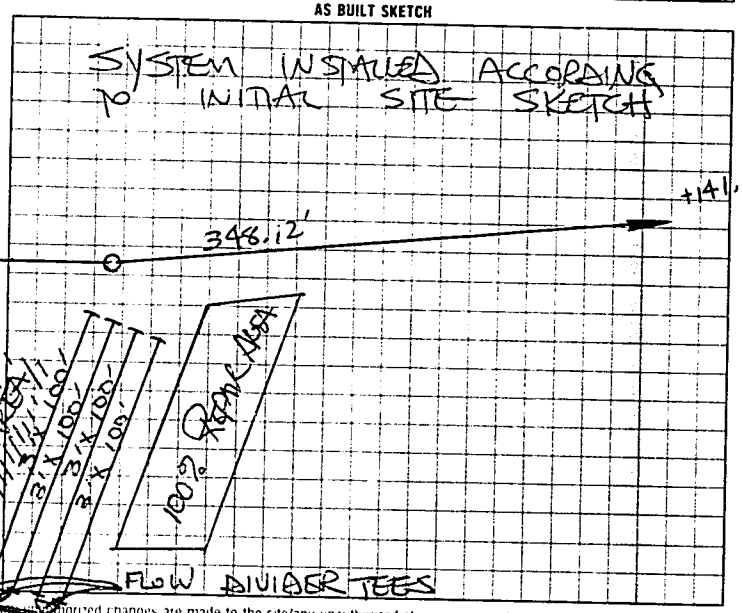

I understand that this permit can be suspended or revoked if any false information is supplied toward securing the permit. Unauthorized changes are made to the site/any unauthorized changes are made in the installation of the system

AUTHORIZATION TO CONSTRUCT IS VALID FIVE (5) YEARS FROM DATE OF ISSUANCE. IMPROVEMENT PERMIT HAS NO EXPIRATION DATE.

Signed +Wallace S. Butler

Improvement Permit by STEVE HEDRICK date 3-19-96

AUTHORIZATION TO CONSTRUCT

Existing System Inspection by STEVE HEDRICK date 3-19-96

Installed by TOMMY FRYE

Certificate of Completion by

Operation Permit by STEVE HEDRICK date 5-1-96

HEALTH DEPT COPY WHITE | INSPECTION COPY (FINAL) GREEN | OWNER COPY (FINAL) YELLOW | INSPECTION COPY (INITIAL) PINK | OWNER COPY (INITIAL) GOLD