RAYMOND & MARJORIE PAYNE

IREDELL COUNTY HEALTH DEPARTMENT

STATESVILLE 704-878-5305 MOORESVILLE 704-664-5281

IMPROVEMENT PERMIT / CERTIFICATE OF COMPLETION / OPERATION PERMIT / EXISTING SYSTEM INSPECTION

PROPERTY DESCRIPTION NO. 065799 DATE 4-14-97 TAX MAP NO. 4861 22 05 13 Watershed: ☐ Yes ☒ No

OWNER OR CONTRACTOR ANGIE ROBERTS PHONE: Business Home 539-4051

ADDRESS 1410 FOREST PARK DRIVE STATESVILLE NC 28677

LOCATION US 21 N, TL TABOR RD, TL SPEAKS RD, TR HAYSTACK LANE 2ND LOT ON LEFT

SUBDIVISION HOLLY BOB ACRES BLOCK / SECTION LOT 20 LOT AREA 0.94 ACRE SITE CLASS. PS DESIGN FLOW 360 L.T.A.R. 0.30 gpd/ft²

Septic Tank: 1000 Gallons; STB 238 Date 9-1-97

Pump Tank: Gallons; PT Date

Pump Make: Model Serial No.

Nitrification Field: No Fields 1 Square Feet 1200 Linear Feet 200

No Lines FOUR Trench Width 24" Max Trench Bottom Depth 36"

☒ New System ☐ Repair System Type: I, II, III, IV, V, VI

System Description: PPBPS, GRAVITY

Repair System Description: PPBPS, PUMP/GRAVITY

Maintenance Agreement Required: ☐ Yes ☒ No

Cover Depth 6" ☐ Slab ☒ Crawl Space ☐ Basement w/plumbing ☐ Basement wo/plumbing

☐ House/Mod. Home No. Bedrooms 3

☒ Mobile Home No. Bathrooms 2

☐ Business No. Employees


☐ Other

Water Supply: ☐ Individual ☐ Community ☒ Public


Comments: ① INSTALL 44 PPBPS PANELS IN FOUR EQUAL LENGTH LINES ON CONTOUR AS SHOWN ② USE THREE FLOW DIVIDER TEES TO ACHIEVE EQUAL DISTRIBUTION INTO EACH OF FOUR LINES

Comments:

INITIAL SITE SKETCH

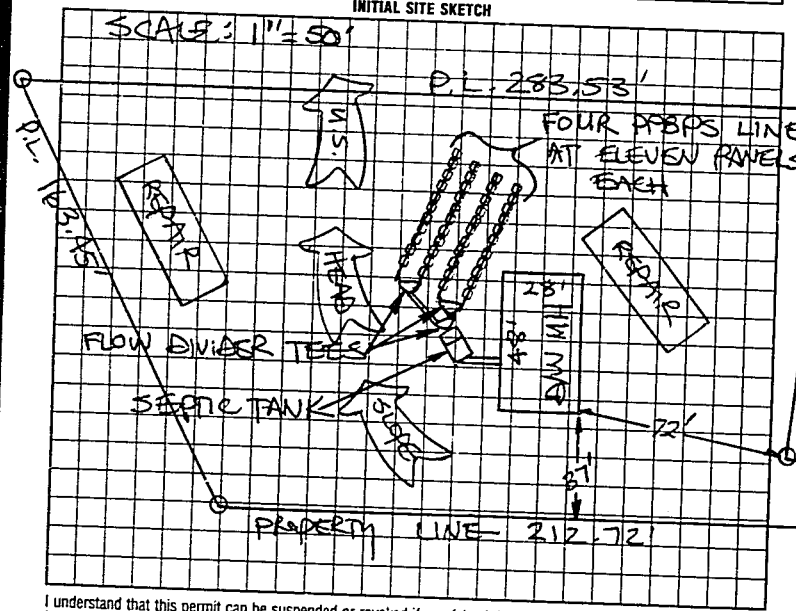

AS BUILT SKETCH

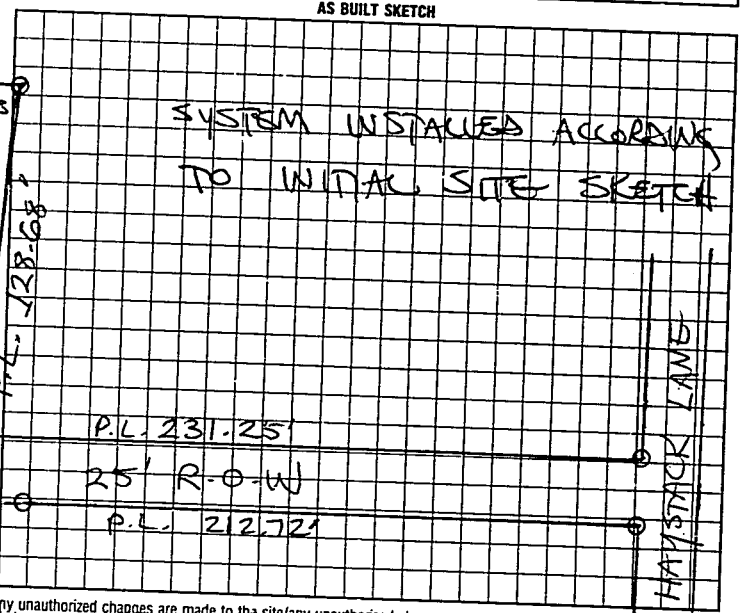

I understand that this permit can be suspended or revoked if any false information is supplied toward securing the permit/any unauthorized changes are made to the site/any unauthorized changes are made in the installation of the system. Improvement Permit is valid for 60 months from date of issuance. AUTHORIZATION TO CONSTRUCT IS VALID FOR 60 MONTHS FROM DATE OF ISSUANCE.

Signed: X Marjorie L Payne

Improvement Permit by: STEVE HEDRICK date 4-14-97

AUTH. TO CONST.

Existing System Inspection by: STEVE HEDRICK date 4-14-97

Installed by: H.B. SALMONS

Certificate of Completion by: date

Operation Permit by: STEVE HEDRICK date 10-31-97

HEALTH DEPT COPY: WHITE INSPECTION COPY (FINAL) GREEN OWNER COPY (FINAL) YELLOW INSPECTION COPY (INITIAL) PINK OWNER COPY (INITIAL) GOLD