Jame Paul Parlier

IREDELL COUNTY HEALTH DEPARTMENT

STATESVILLE 704-878-5305 MOORESVILLE 704-664-5281

IMPROVEMENT PERMIT / CERTIFICATE OF COMPLETION / OPERATION PERMIT / EXISTING SYSTEM INSPECTION

PROPERTY DESCRIPTION NO. 065831 DATE 4-16-97 TAX MAP NO. 4861128549

OWNER OR CONTRACTOR ~~BILLY RAY TRIVETTE~~ Parlier PHONE: Business Watershed: ☐ Yes ☑ No

ADDRESS 356 SHEFFIELD ROAD, HARMONY NC 28634 Home 546-2444

LOCATION US 21 N, TL TABOR ROAD, TL SPEAKS ROAD, TR HAYSTACK LANE, 4th LOT ON LEFT

SUBDIVISION Hall-Bob S/D BLOCK / SECTION LOT 18/17 LOT AREA 0.63 ACRE SITE CLASS PS DESIGN FLOW 360 L.T.A.R. 0.30 GPD/FT²

Septic Tank: 1000 Gallons; STB 1007 Date 3-11-97

Pump Tank: Gallons; PT Date

Pump Make: Model Serial No.

Nitrification Field: No Fields 1 Square Feet Eq. To 1200 Linear Feet 300+

No Lines FOUR Trench Width 36" Max Trench Bottom Depth 36"

☑ New System ☐ Repair System Type: I, II, (III), IV, V, VI

System Description: CHAMBERED GRAVITY

Repair System Description: CHAMBERED PUMP

Maintenance Agreement Required: ☐ Yes ☑ No

☐ House/Mod. Home ☑ Mobile Home ☐ Business ☐ Other

No. Bedrooms 3 No. Bathrooms 2 No. Employees


☐ Slab ☑ Crawl Space ☐ Basement w/plumbing ☐ Basement wo/plumbing

Water Supply: ☐ Individual ☐ Community ☑ Public


Comments: LOT 17 & 18 COMBINED ① INSTALL 52 CHAMBERS IN FOUR EQUAL LENGTH LINES ON CONTOUR AS SHOWN AND FLAGGED ③ USE THREE FLOW DIVIDER TEES TO ACHIEVE EQUAL DISTRIBUTION INTO EACH OF FOUR LINES.

Comments:

INITIAL SITE SKETCH

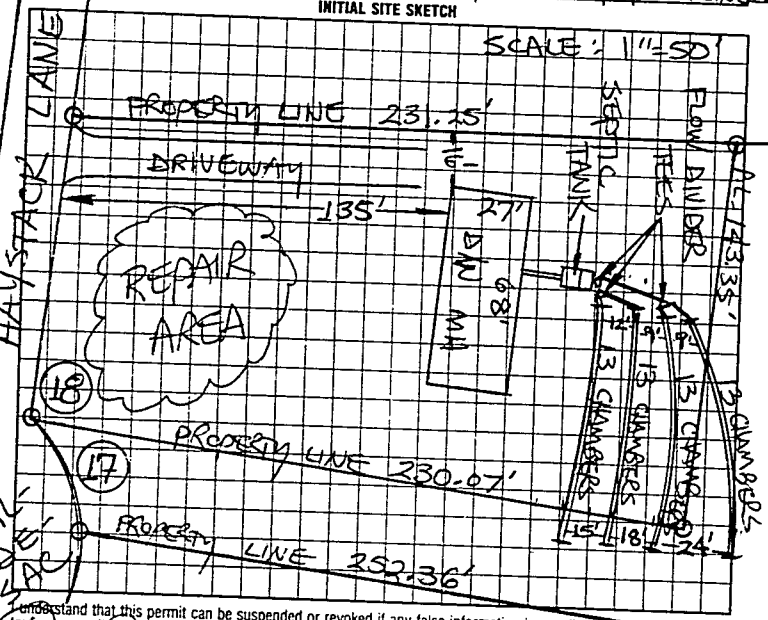

AS BUILT SKETCH

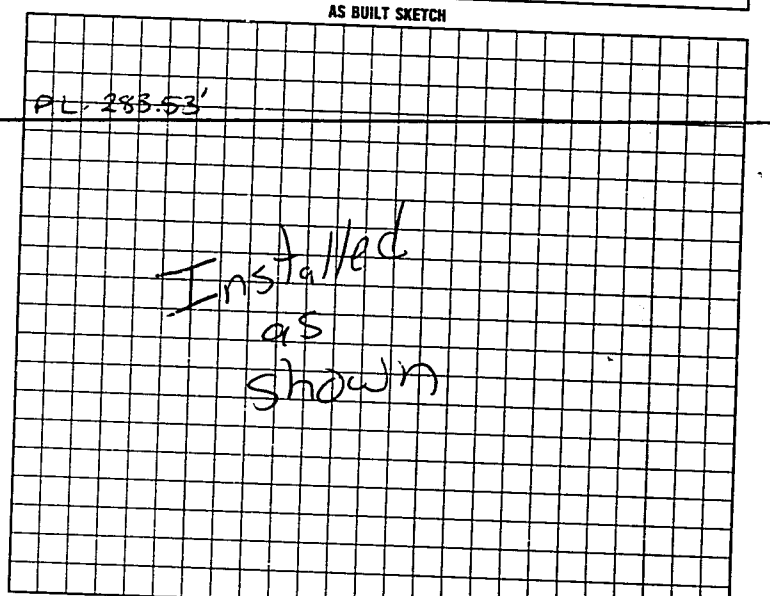

I understand that this permit can be suspended or revoked if any false information is supplied toward securing the permit/any unauthorized changes are made to the site/any unauthorized changes are made in the installation of the system. Improvement Permit is valid for 60 months from date of issuance. AUTHORIZATION TO CONSTRUCT VOID AFTER 60 MONTHS FROM DATE OF ISSUANCE.

Signed:

Improvement Permit by: STEVE HEDRICK date 4-16-97

AUTH. TO CONST.

~~Certificate of Completion by:~~ Installed by: James Hudder

Existing System Inspection by: STEVE HEDRICK date 4-16-97

Operation Permit by: Mark C. Outlaw date 4-25-97

HEALTH DEPT. COPY: WHITE | INSPECTION COPY (FINAL): GREEN | OWNER COPY (FINAL): YELLOW | INSPECTION COPY (INITIAL): PINK | OWNER COPY (INITIAL): GOLD