IREDELL COUNTY HEALTH DEPARTMENT

STATESVILLE 704-878-5305 MOORESVILLE 704-664-5281

IMPROVEMENT PERMIT / AUTHORIZATION TO CONSTRUCT / OPERATION PERMIT / EXISTING SYSTEM INSPECTION

PERMIT# 090686 PIN# 486 12 25690 DATE July 25, 2000

OWNER OR CONTRACTOR A Homes America PHONE: Business 592-2202 Home

ADDRESS P.O. Box 46 Union Grove N.C. 28689

LOCATION I77N TR Tomlin Mill Rd ~~to~~ END TL Tabor Rd. ~1/4 mile past Turkeys Restaurant TL Speaks Rd on left (Across from Hayshack Lane)

SUBDIVISION Padgett Farms BLOCK / SECTION LOT 13 LOT AREA .6Ac SITE CLASS. S DESIGN FLOW 360gpd L.T.A.R. .3

Septic Tank: 1000 Gallons; STB 819 Date 7-17-00

Pump Tank: Gallons; PT Date

Pump Make: Model Serial No.

Nitrification Field: No Fields 1 Square Feet 1200 Linear Feet 400

No Lines 5 Trench Width 36" Max Trench Bottom Depth 36" Gravel Depth 12"

☑ New System ☐ Repair System Type: I, II, III, IV, V, VI

System Description: GRAVITY CONVENTIONAL

Repair System Description: GRAVITY CONVENTIONAL OR INNOVATIVE

Maintenance Agreement Required: ☐ Yes ☑ No 25% Red.

☑ House/Mod. Home No. Bedrooms 3

☐ Mobile Home No. Bathrooms 2

☐ Business No. Employees

☐ Other


☐ Slab ☑ Crawl Space ☐ Basement w/plumbing ☐ Basement wo/plumbing

Water Supply: ☐ Individual ☑ Public ☐ Community

Comments/Conditions:

Comments/Conditions: SEPTIC TANK W/ MARKER INSTALLED USING "MPTITE" FILTER

INITIAL SITE SKETCH 1" = 40'

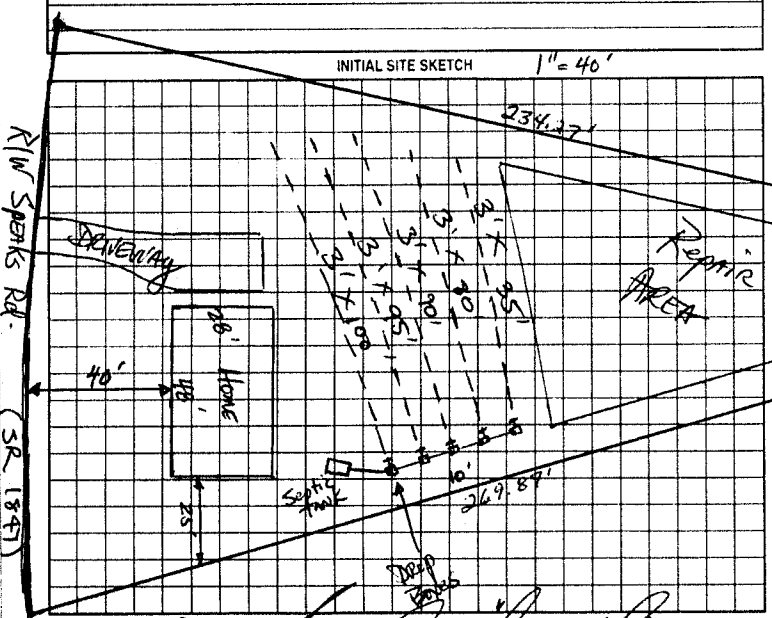

AS BUILT SKETCH

AS SHOWN

Permit can be suspended or revoked if any false information is supplied toward securing the permit/any unauthorized changes are made to the site/any unauthorized changes are made in the installation of the system. Improvement Permit with plat valid without expiration. Improvement Permit with site plan valid for sixty months. Authorization to Construct is valid for a period equal to that of Improvement Permit – not to exceed sixty months.

Signed: date 7-26-00 Installed by: DAVID UMBARGER

Improvement Permit by: date 7-25-00 Operation Permit by: STEVE HERRICK date 9-25-00

Authorization to Construct by: date 7-25-00 Existing System Inspection by: date

HEALTH DEPT COPY: WHITE OWNER COPY (FINAL): YELLOW OWNER COPY (INITIAL): PINK