IREDELL COUNTY HEALTH DEPARTMENT

STATESVILLE 704-878-5305 MOORESVILLE 704-664-5281

IMPROVEMENT PERMIT / AUTHORIZATION TO CONSTRUCT / OPERATION PERMIT / EXISTING SYSTEM INSPECTION

PERMIT# 082152 PIN# 4861 22 5931 DATE 7-6-99

OWNER OR CONTRACTOR ROCKY KISER PHONE: Business Home 872-1075

ADDRESS 518 WISE STREET STATESVILLE, NC 28677

LOCATION US 21 N, TL [redacted] ROAD, 1 TL SPEAKS ROAD, 2ND LOT ON RIGHT BEFORE HAYSTACK LANE

SUBDIVISION HOLLY BOB BLOCK / SECTION ABOR LOT 6 LOT AREA 0.78 ACRE SITE CLASS PS DESIGN FLOW 360 L.T.A.R. 0.30 GPD/FT²

Septic Tank: 1000 Gallons; STB 1012 Date 6-30-99

Pump Tank: 1000 Gallons; PT 17 Date 5-11-99

Pump Make: Hydromatic Model SK50A1 Serial No 5161-40107

Nitrification Field: No Fields ___ Square Feet ___ Linear Feet 300+

No Lines FIVE Trench Width 36" Max Trench Bottom Depth 30" Gravel Depth SAND 6"

☑ New System ☐ Repair System Type: I II (III) IV V VI

System Description: 25% REDUCTION, pump

Repair System Description: 25% REDUCTION, pump

Maintenance Agreement Required: ☐ Yes ☑ No

☐ House/Mod. Home No. Bedrooms 3

☑ Mobile Home No. Bathrooms 2

☐ Business No. Employees ___

☐ Other ___


☐ Slab ☑ Crawl Space ☐ Basement w/plumbing ☐ Basement wo/plumbing

Water Supply: ☐ Individual ☑ Public ☐ Community

Comments/Conditions: INSTALL 25% REDUCTION SYSTEM USING FIFTY (50) CHAMBERS OR THIRTY-SIX (36) HDS SECTIONS ② SEE ATTACHED SHEETS FOR PUMP AND PRESSURE MANIFOLD REQUIREMENTS

Comments/Conditions: 1-1 Inspected Tanks, Lines, cycled pump ws

INITIAL SITE SKETCH

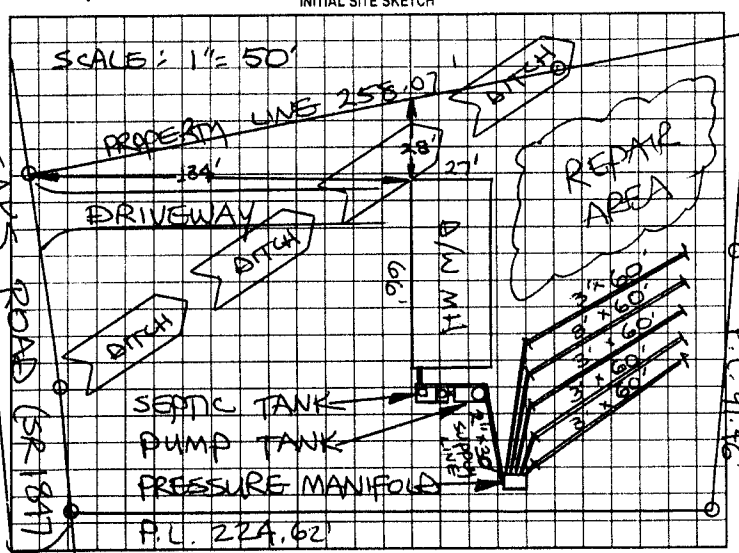

AS BUILT SKETCH

SYSTEM INSTALLED ACCORDING TO INITIAL SITE SKETCH

Permit can be suspended or revoked if any false information is supplied toward securing the permit/any unauthorized changes are made to the site/any unauthorized changes are made in the installation of the system. Improvement Permit with plat valid without expiration. Improvement Permit with site plan valid for sixty months. Authorization to Construct is valid for a period equal to that of Improvement Permit – not to exceed sixty months.

Signed: Gary Kiser date 7-7-99

Improvement Permit by: STEVE HEDRICK date 7-6-99

Authorization to Construct by: STEVE HEDRICK date 7-6-99

Installed by: A-1 BACKHOE

Operation Permit by: STEVE HEDRICK date 12-10-99

Existing System Inspection by: ___ date ___

HEALTH DEPT COPY WHITE OWNER COPY (FINAL) YELLOW OWNER COPY (INITIAL) PINK