IREDELL COUNTY HEALTH DEPARTMENT (41) STATESVILLE 704-878-5305 MOORESVILLE 704-664-5281

IMPROVEMENT PERMIT / AUTHORIZATION TO CONSTRUCT / OPERATION PERMIT / EXISTING SYSTEM INSPECTION

PERMIT# 103467 PIN# 4861-22-6696 DATE 12-5-01

OWNER OR CONTRACTOR JOHN BULBOFF PHONE Business Home (704) 871-8544

ADDRESS 1848-A SIMONTON ROAD, STATESVILLE, NC 28625

LOCATION US 21 NORTH, TL TABOR ROAD, TL SPEAKS ROAD, 0.3 MILE ON LEFT AT LOT #12

SUBDIVISION PADGETT FARMS BLOCK / SECTION LOT 12 LOT AREA 0.551 ACRES SITE CLASS PS DESIGN FLOW 360 L.T.A.R. 0.30 600/FT²

Septic Tank: 1000 Gallons. STB 1012 Date 02/19/02
Pump Tank: Gallons. PT Date
Pump Make: Model Serial No
Nitrification Field: No Fields 1 Square Feet 1200 Linear Feet 400
No Lines FIVE Trench Width 36" Max Trench Bottom Depth 36" Gravel Depth 12"

~~New System~~ Repair System Type I II III IV V
System Description: CONVENTIONAL GRAVITY
Repair System Description: 50% REDUCTION, GRAVITY
Maintenance Agreement Required: Yes ~~No~~


~~House/Mod Home~~ Mobile Home ~~Business~~ Other
No Bedrooms 3 No Bathrooms 2 No Employees
Slab ✓Crawl Space Basement w/plumbing Basement wo/plumbing

Water Supply: ☐ Individual ☒ Public ☐ Community

Comments/Conditions:

Comments/Conditions: Septic tank with marker installed using "Polylock" filter

INITIAL SITE SKETCH SCALE: 1"=40'

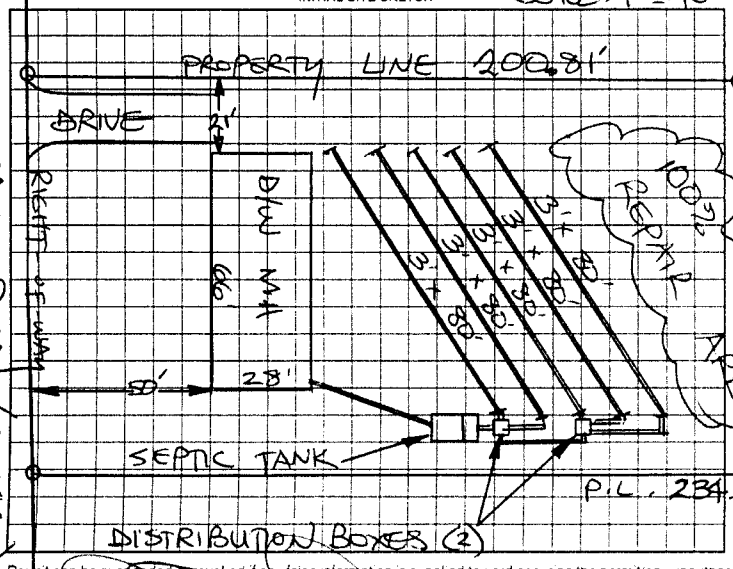

AS BUILT SKETCH

* SYSTEM INSTALLED ACCORDING TO INITIAL SITE SKETCH

Permit can be suspended or revoked if any false information is supplied toward securing the permit/any unauthorized changes are made to the site any unauthorized changes are made in the installation of the system. Improvement Permit with plat valid without expiration. Improvement Permit with site plan valid for sixty months. Authorization to Construct is valid for a period equal to that of Improvement Permit - not to exceed sixty months.

Signed: [signature] date 12-5-01 Installed by: A-1 BACKHOE

Improvement Permit by: STEVE HEDRICK date 12-5-01 Operation Permit by: STEVE HEDRICK date 6-20-02

Authorization to Construct by: STEVE HEDRICK date 12-5-01 Existing System Inspection by: date

HEALTH DEPT. COPY WHITE OWNER COPY (FINAL) YELLOW OWNER COPY (INITIAL) PINK