IREDELL COUNTY HEALTH DEPARTMENT

STATESVILLE 704-878-5305 MOORESVILLE 704-664-5281

IMPROVEMENT PERMIT / AUTHORIZATION TO CONSTRUCT / OPERATION PERMIT / EXISTING SYSTEM INSPECTION

PERMIT# 990687 PIN# 4866172879 8 DATE July 25, 2000

OWNER OR CONTRACTOR A Homes America PHONE: Business 592-2202 Home

ADDRESS P.O. Box 46 Union Grove, N.C. 28689

LOCATION I77N TR Tomlin Mill Rd. to End TL Tabor Rd. ~¼ mile past Jurneys Rest Homes TL Speaks Rd ~¼ mile on left

SUBDIVISION Padgett Farms BLOCK / SECTION LOT 10 LOT AREA .53 Ac SITE CLASS PS DESIGN FLOW 360 gpd L.T.A.R. ~.25 gal/sq ft/day

Septic Tank: 1000 Gallons; STB 160 Date 10-23-00
Pump Tank: Gallons; P/ Date
Pump Make: Model Serial No.
Nitrification Field: No Fields 1 Square Feet 1080 Linear Feet ~360
No Lines 4 5 Trench Width 36" Max Trench Bottom Depth 36"

New System / Repair System Type: I II III IV V
System Description: Gravity Innovative - 25% Reduction
Repair System Description Gravity pumped Innovative -25% Red.
Maintenance Agreement Required: Yes / No
Gravel Depth NA
Slab / Crawl Space Basement w/plumbing Basement wo/plumbing


House/Mod. Home No. Bedrooms 3
Mobile Home No. Bathrooms 2
Business No. Employees
Other

Water Supply: Individual / Public / Community


Comments/Conditions: ① ONE inspection port per lateral set flush with finished grade. If plastic chambers are used, install 1S per lateral, if space allows (14 per lateral minimum)

Comments/Conditions: ① 60 "BIODIFFUSER" CHAMBERS INSTALLED IN FIVE LINES AS SHOWN ② SEPTIC TANK WITH MARKER INSTALLED USING "ZABEL" FILTER ③ SOIL SHOWS CHROMA 2 MOTTLING

INITIAL SITE SKETCH

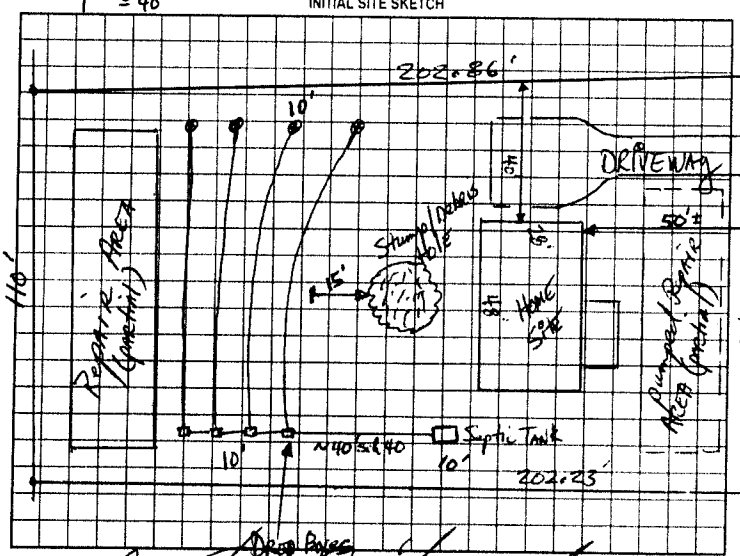

AS BUILT SKETCH

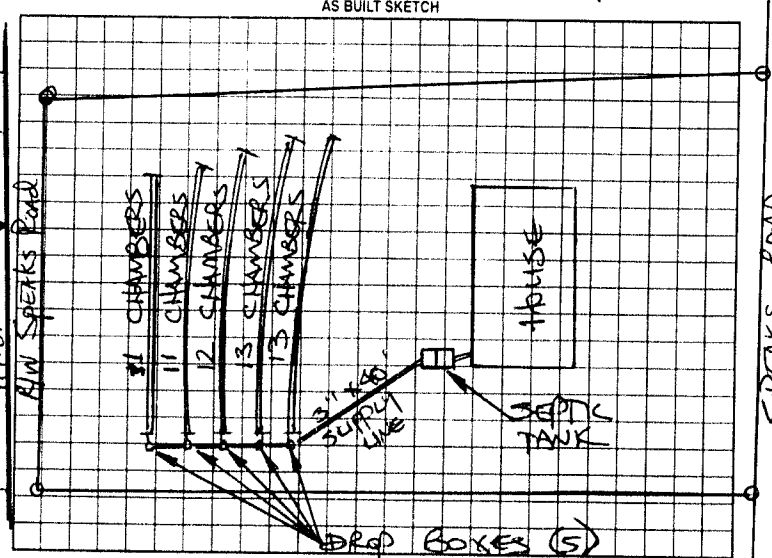

Permit can be suspended or revoked if any false information is supplied toward securing the permit; any unauthorized changes are made to the site; any unauthorized changes are made in the installation of the system. Improvement Permit with plat valid without expiration. Improvement Permit with site plan valid for sixty months. Authorization to Construct is valid for a period equal to that of Improvement Permit - not to exceed sixty months.

Signed: date 7-26-00 Installed by DAVID UNBARGER

Improvement Permit by: date 7-25-00 Operation Permit by: STEVE HEDRICK date 4-30-01

Authorization to Construct by: date 7-25-00 Existing System Inspection by: date

HEALTH DEPT COPY WHITE OWNER COPY (FINAL) YELLOW OWNER COPY (INITIAL) PINK