Linda Hackenberry → Authorization to Construct 61328

IREDELL COUNTY HEALTH DEPARTMENT

STATESVILLE 704-878-5305 MOORESVILLE 704-664-5281

IMPROVEMENT PERMIT / ~~CERTIFICATE OF COMPLETION~~ / OPERATION PERMIT / EXISTING SYSTEM INSPECTION

PROPERTY DESCRIPTION NO. 23666 DATE 4/27/96 TAX MAP NO. 16A-1-12 Watershed: ☐ Yes ☒ No

OWNER OR CONTRACTOR Linda Hackenberry - Robert Hackenberry PHONE: Business _____ Home 664-3758

ADDRESS 756-65 White Oak Dr Mooresville NC 28115

LOCATION 21 N - Tabor Rd - N (T) Speaks Rd - TR Haystack - end of Rd at end of Cul-de-sac

SUBDIVISION Holly Bob Farms BLOCK / SECTION _____ LOT 12 LOT AREA ± 3 ac SITE CLASS PS DESIGN FLOW 360 gpd L.T.A.R. .3 gpd/ft

Septic Tank: 1000 or 1500 Gallons; STB _____ Date _____

Pump Tank: _____ Gallons; PT _____ Date _____

Pump Make: _____ Model _____ Serial No. _____

Nitrification Field: No Fields 1 Square Feet 1200 Linear Feet 400

No Lines 3 Trench Width 36" Max Trench Bottom Depth 24-30" Gravel Depth 12"

☒ New System ☐ Repair System Type: I (II) III. IV. V. VI

System Description: Gravity Conventional

Repair System Description: Conventional

Maintenance Agreement Required: ☐ Yes ☒ No

☒ House/Mod. Home No. Bedrooms 3

☐ Mobile Home No. Bathrooms 2

☐ Business No. Employees _____

☐ Other _____


☐ Slab ☒ Crawl Space ☐ Basement w/plumbing ☒ Basement wo/plumbing

Water Supply: ☐ Individual ☐ Community ☒ Public


Comments:

Comments: SYSTEM INSTALLED AS SHOWN BELOW

INITIAL SITE SKETCH 651'

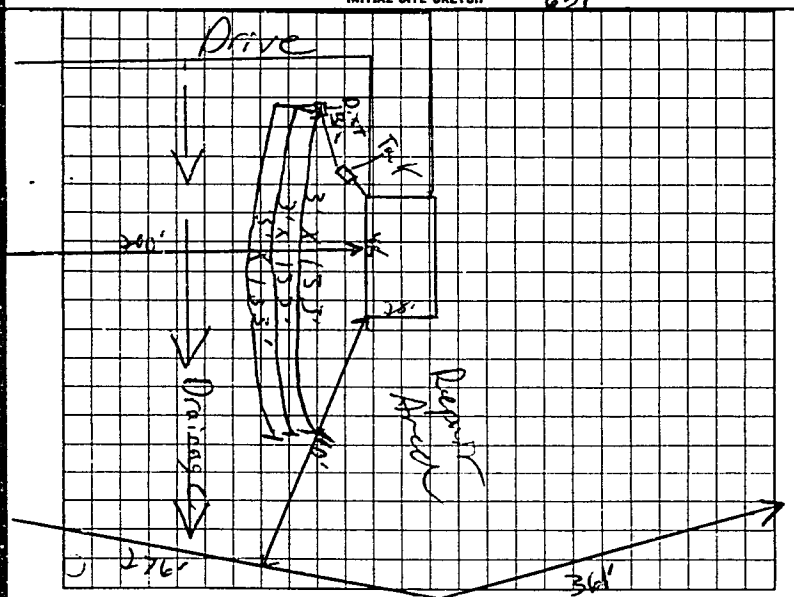

AS BUILT SKETCH

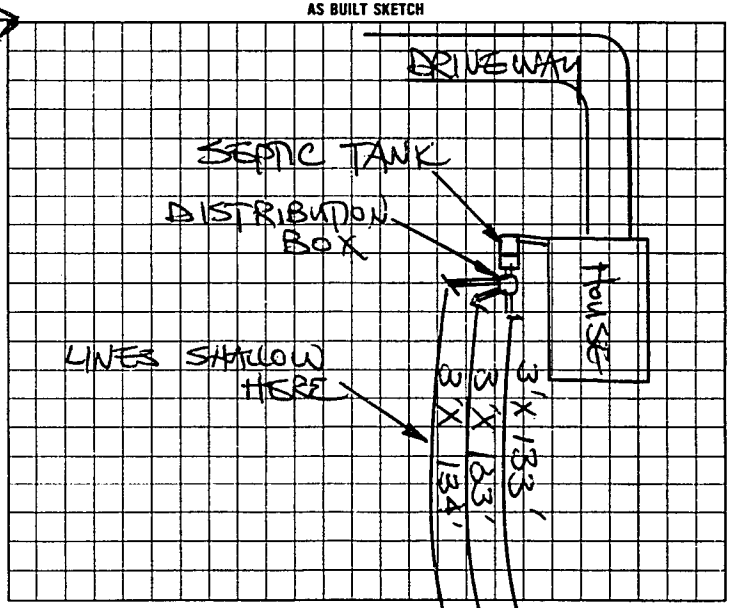

I understand that this permit can be suspended or revoked if any false information is supplied toward securing the permit/any unauthorized changes are made to the site/any unauthorized changes are made in the installation of the system.

Authorization to Construct is valid for 60 months from issue date.

Signed: Robert K. Hackenberry

Installed by: J.C's BACKHOE SERVICE

Improvement Permit by: C. Brady Strawn EHSI date 4/27/96

Certificate of Completion by: _____ date _____

Existing System Inspection by: C. Brady Strawn EHSI date 4/27/96

Operation Permit by STEVE HEFRICK date 7-5-96

HEALTH DEPT. COPY: WHITE INSPECTION COPY (FINAL): GREEN OWNER COPY (FINAL): YELLOW INSPECTION COPY (INITIAL): PINK OWNER COPY (INITIAL): GOLD

SS7000