IREDELL COUNTY HEALTH DEPARTMENT

STATESVILLE 704-878-5305 MOORESVILLE 704-664-5281

IMPROVEMENT PERMIT / AUTHORIZATION TO CONSTRUCT / OPERATION PERMIT / EXISTING SYSTEM INSPECTION

PERMIT# 130502 PIN# 4846123 8022 DATE 1-19-07

OWNER OR APPLICANT First Choice PHONE: Business 704-902-7308 Home

ADDRESS 114 Beechnut Lane Statesville NC 28625

LOCATION 21W (TL) Tharpe (TL) Sprague 1.2 Mile on Right RS

SUBDIVISION Holly Tree BLOCK / SECTION LOT 5 LOT AREA 1.68 AC SITE CLASS. RS DESIGN FLOW 480 L.T.A.R. 1.3

Septic Tank: 1000 Gallons; STB 1000 Date 8-25-06

Pump Tank: Gallons; PT Date

Pump Make: Model Serial No.

Nitrification Field: No Fields Square Feet 1440 Linear Feet 400

No Lines 5 Trench Width 36 Max Trench Bottom Depth 36" Gravel Depth

☐ New System ☐ Repair ☐ Expansion System Type: I (II) III IV V VI

System Description: 25% Curtain

Repair System Description: 25% Curtain

Maintenance Agreement Required: ☐ Yes ☐ No

☐ House/Mod. Home No. Bedrooms 4

☐ Mobile Home No. Persons

☐ Business No. Employees

☐ Other


Water Supply: ☐ Individual ☒ Public ☐ Community

☐ Gravity ☐ Pressure ☐ Slab ☒ Crawl Space ☐ Basement w/plumbing ☐ Basement wo/plumbing


Comments:/Conditions: Uninstall on Curtain Maintain all Setbacks

Comments:/Conditions: Yellow Flag 5' marker 1" = 40'

INITIAL SITE SKETCH 20'

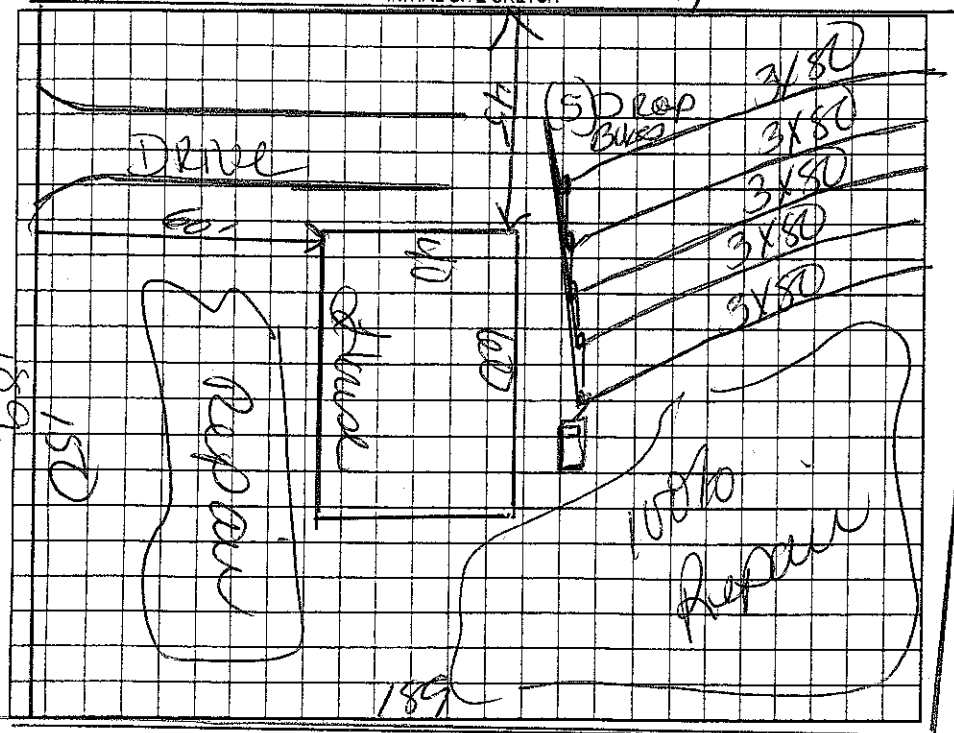

AS BUILT SKETCH

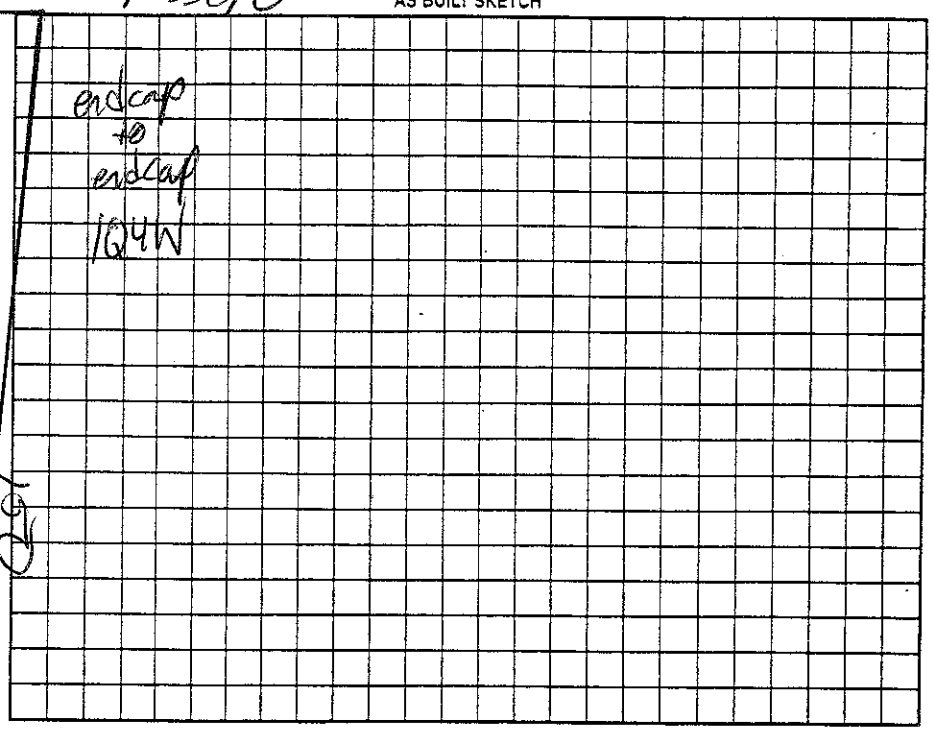

Permit can be suspended or revoked if any false information is supplied toward securing the permit/any unauthorized changes are made to the site/any unauthorized changes are made in the installation of the system. Improvement Permit with plat valid without expiration ☐ Improvement Permit with site plan valid for sixty months ☐ Authorization to Construct is valid for a period equal to that of Improvement Permit – not to exceed sixty months.

Signed: date

Improvement Permit by: date 1-19-07

Authorization to Construct by: date 1-19-07

Installed by: A-1 Backhoe

Operation Permit by: date 2-28-07

Existing System Inspection by: date

HEALTH DEPT. COPY: WHITE OWNER COPY (FINAL): YELLOW OWNER COPY (INITIAL): PINK