IREDELL COUNTY HEALTH DEPARTMENT

STATESVILLE 704-878-5305 MOORESVILLE 704-664-5281

IMPROVEMENT PERMIT / AUTHORIZATION TO CONSTRUCT / OPERATION PERMIT / EXISTING SYSTEM INSPECTION

PERMIT# 080777 PIN# 4861 23 9068 DATE 4-29-99

OWNER OR CONTRACTOR RODOLFO FERRETTE PHONE: Business Home 592-2157

ADDRESS 480 MASON FARM ROAD, STATESVILLE NC 28625

LOCATION US 21 N, TL TABOR RD, TL SPEAKS ROAD, 10.3 MILE ON RIGHT

SUBDIVISION Holly-Bob BLOCK / SECTION LOT 2 LOT AREA 0.63 ACRE SITE CLASS PS DESIGN FLOW 360 L.T.A.R. 0.30 GPD/FT²

Septic Tank: 1000 Gallons, STB 794 Date 11-21-98

Pump Tank: Gallons, PT Date

Pump Make: Model Serial No.

Nitrification Field: No. Fields 1 Square Feet 1200 Linear Feet 400

No. Lines FIVE Trench Width 36" Max. Trench Bottom Depth 36" Gravel Depth 12"

☑ New System ☐ Repair System Type ☐ II ☐ III ☐ IV ☐ V ☐ VI

System Description: CONVENTIONAL GRAVITY

Repair System Description: CONV. PUMP

Maintenance Agreement Required ☐ Yes ☑ No

☐ House/Mod. Home ☑ Mobile Home ☐ Business ☐ Other

No. Bedrooms 3 No. Bathrooms 2 No. Employees


☐ Slab ☑ Crawl Space ☐ Basement w/plumbing ☐ Basement wo/plumbing

Water Supply: ☐ Individual ☑ Public ☐ Community

Comments /Conditions

Comments /Conditions

INITIAL SITE SKETCH SCALE: 1"=40'

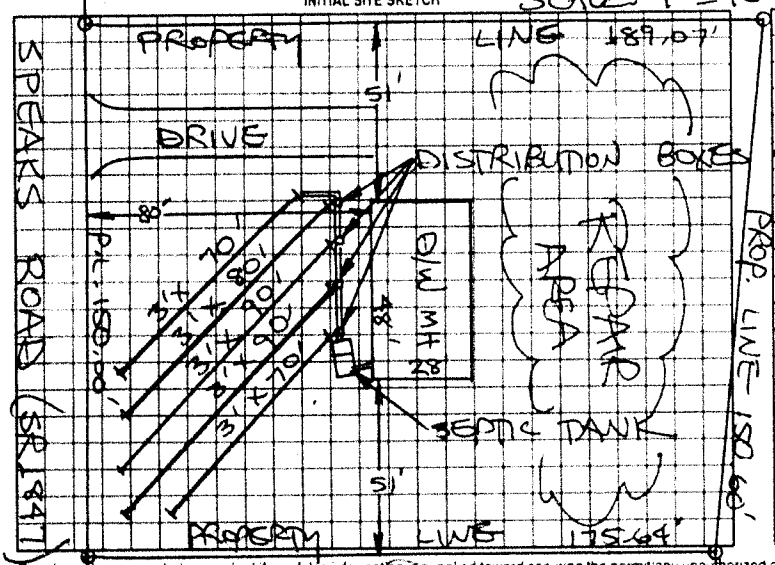

AS BUILT SKETCH

Installed as shown

Permit can be suspended or revoked if any false information is supplied toward securing the permit; any unauthorized changes are made to the site; any unauthorized changes are made in the installation of the system. Improvement Permit will not valid without expiration. Improvement Permit with site plan valid for sixty months. Authorization to Construct is valid for a period equal to that of Improvement Permit - not to exceed sixty months.

Signed: date 4/29/99 Installed by Atlantic Ex.

Improvement Permit by STEVE HEDRICK date 4-29-99 Operation Permit by [illegible] RS date 5-5-99

Authorization to Construct by STEVE HEDRICK date 4-29-99 Existing System Inspection by date

HEALTH DEPT COPY WHITE OWNER COPY (FINAL) YELLOW OWNER COPY (INITIAL) PINK