IREDELL COUNTY HEALTH DEPARTMENT

STATESVILLE 704-878-5305 MOORESVILLE 704-664-5281

IMPROVEMENT PERMIT / CERTIFICATE OF COMPLETION / OPERATION PERMIT / EXISTING SYSTEM INSPECTION

PROPERTY DESCRIPTION NO. 16447 DATE 6/14/93 TAX MAP NO. 16A-A-57

OWNER OR CONTRACTOR DOUG A. HEDGECOCK PHONE: Business Home (919) 869-3778

ADDRESS 3834 WATERVIEW ROAD HIGH POINT NC

LOCATION US 21 N, TL TABOR ROAD, ON (L) PAST WILLIAMSBURG ROAD, 2ND (R) ON (L)

SUBDIVISION BLOCK / SECTION LOT LOT AREA 23.31 SITE CLASS. PS1 L.T.A.R. 0.35 GPD/FT²

Water Supply: ☐ Individual ☐ Community ☑ Public

Septic Tank: 1000 Gallons; STB 620 Date 5/3/93

Pump Tank: Gallons; PT Date

Nitrification Field: No Fields 1 Square Feet 1035 Linear Feet 345

No Lines 3 Trench Width 36" Trench Depth 36" Gravel Depth 12"

☑ New System ☐ Repair System Type: I, II, III, IV, V, VI

System Description: CONV. GRAVITY

Repair System Description: CONV. GRAVITY

Maintenance Agreement Required: ☐ Yes ☑ No

☑ House/Mod. Home FUTURE No. Bedrooms 3 Garbage Disposal: ☐ Yes ☑ No

☐ Mobile Home CAMPER No. Bathrooms 2 Auto. Dishwasher: ☑ Yes ☐ No


☐ Business No. Employees Auto. Washing Machine: ☑ Yes ☐ No

☐ Other Other

☐ Slab ☑ Crawl Space ☐ Basement w/plumbing ☐ Basement wo/plumbing

Comments SYSTEM SIZED FOR FUTURE 3BR HOUSE

INITIAL SITE SKETCH

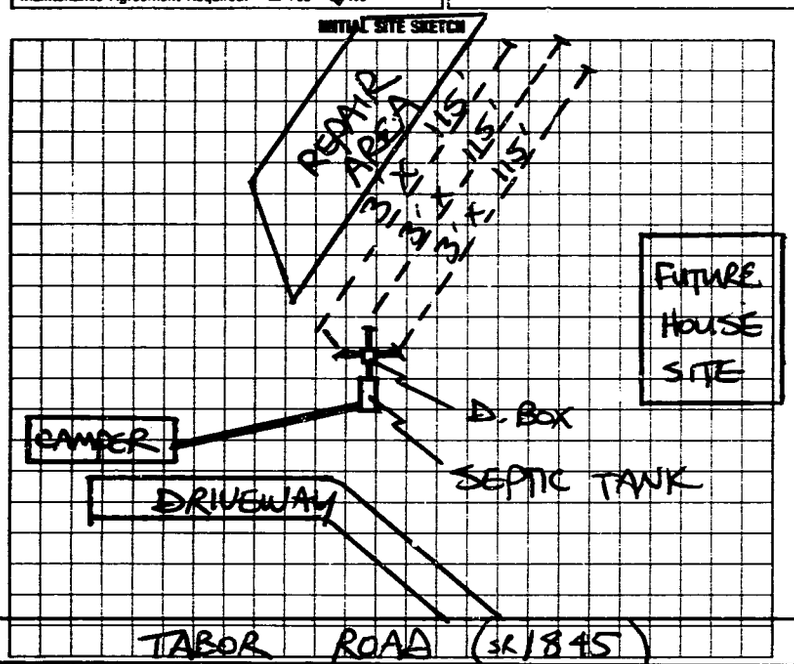

AS BUILT SKETCH

SYSTEM INSTALLED ACCORDING TO INITIAL SITE SKETCH

I understand that this permit can be suspended or revoked if any false information is supplied toward securing the permit/any unauthorized changes are made to the site/any unauthorized changes are made in the installation of the system. Improvement Permit is valid for 60 months from date of issuance.

Signed: Doug Hedgecock

Improvement Permit by: STEVE HEDRICK date 6/14/93

Existing System Inspection by: date

Installed by: SAMMY REAVIS

Certificate of Completion by: STEVE HEDRICK date 6/25/93

Operation Permit by: date

HEALTH DEPT. COPY: WHITE INSPECTION COPY (FINAL): GREEN OWNER COPY (FINAL): YELLOW INSPECTION COPY (INITIAL): PINK OWNER COPY (INITIAL): GOLD