3:00

IREDELL COUNTY HEALTH DEPARTMENT

STATESVILLE 704-878-5305 (CI) MOORESVILLE 704-664-5281

IMPROVEMENT PERMIT / AUTHORIZATION TO CONSTRUCT / OPERATION PERMIT / EXISTING SYSTEM INSPECTION

PERMIT# 145256 PIN# 4861321839 DATE 9-26-07

OWNER OR APPLICANT Wesley Communication Development PHONE: Business 704 924 8942 Home

ADDRESS 149 Speaks Rd.

LOCATION Hwy 21N, L on Tabor, L on Speaks on (L)

SUBDIVISION Pudgett Farms BLOCK / SECTION LOT 8 LOT AREA .512 SITE CLASS RS DESIGN FLOW 360 L.T.A.R. # 3

Septic Tank: 1000 Gallons: STB 1057 Date 10/25/07

Pump Tank: Gallons: PT Date

Pump Make: Model Serial No.

Nitrification Field: No Fields Square Feet Linear Feet 300

No Lines 4 Trench Width 36" Max Trench Bottom Depth 36"

☒ New System ☐ Repair ☐ Expansion System Type: I (II) III IV V VI

System Description: 25% Reduction Gravity

Repair System Description: 25% Reduction Pump

Maintenance Agreement Required: ☐ Yes ☒ No

Gravel Depth n/a ☒ Gravity ☐ Pressure

☒ House/Mod. Home ☐ Mobile Home ☐ Business ☐ Other

No. Bedrooms 3 No. Persons No. Employees

Water Supply: ☒ Individual ☒ Public ☐ Community


☐ Slab ☒ Crawl Space ☐ Basement w/plumbing ☐ Basement wo/plumbing

Comments:/Conditions:


Comments:/Conditions:

Brown Filter

INITIAL SITE SKETCH

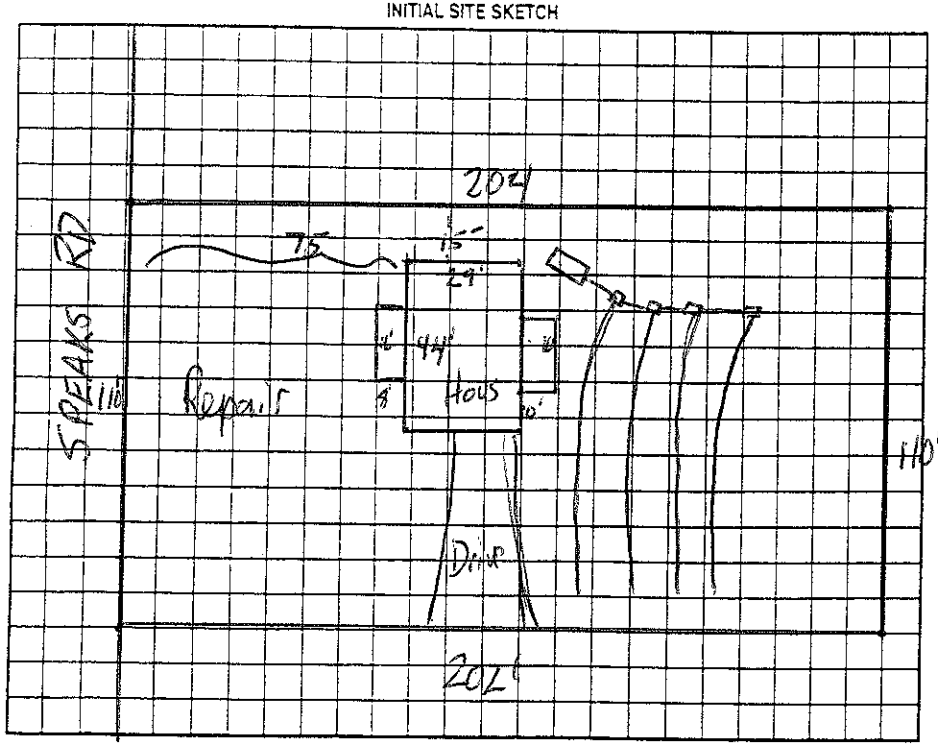

AS BUILT SKETCH

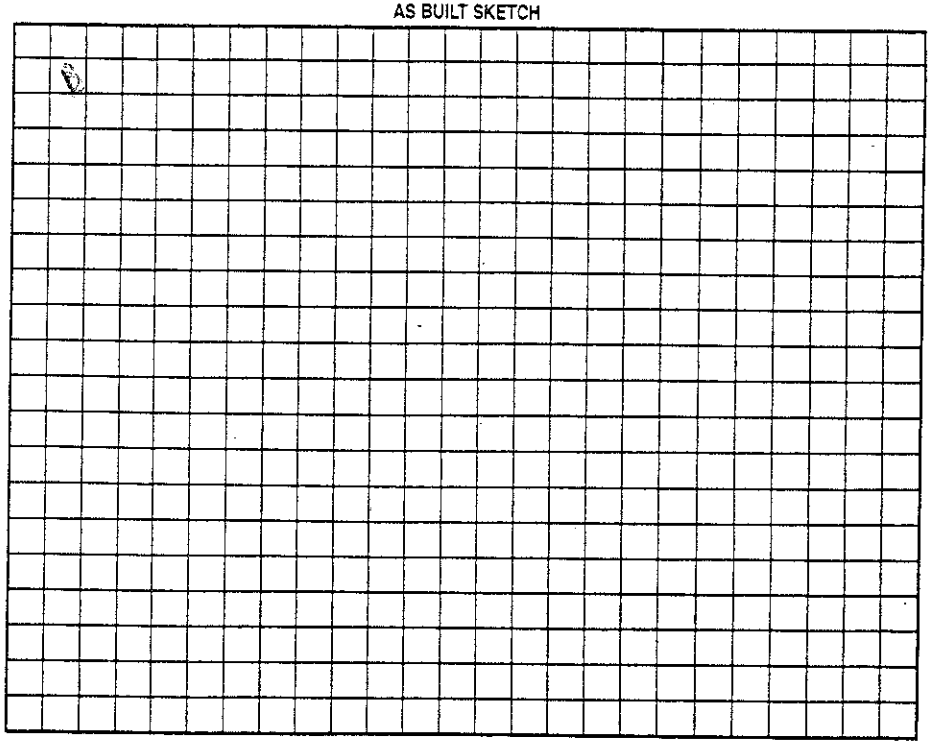

Permit can be suspended or revoked if any false information is supplied toward securing the permit/any unauthorized changes are made to the site/any unauthorized changes are made in the installation of the system. Improvement Permit with plat valid without expiration ☐ Improvement Permit with site plan valid for sixty months ☒ Authorization to Construct is valid for a period equal to that of Improvement Permit – not to exceed sixty months.

Signed: date

Improvement Permit by: date 9-26-07

Authorization to Construct by: date 9-26-07

Installed by: Cothren & Sons

Operation Permit by: date 12-4-07

Existing System Inspection by: date

HEALTH DEPT. COPY: WHITE OWNER COPY (FINAL): YELLOW OWNER COPY (INITIAL): PINK