IREDELL COUNTY HEALTH DEPARTMENT

STATESVILLE 704-878-5305 MOORESVILLE 704-664-5281

IMPROVEMENT PERMIT / AUTHORIZATION TO CONSTRUCT / OPERATION PERMIT / EXISTING SYSTEM INSPECTION

PERMIT# 107109 PIN# 4861-32-2933 DATE 07/03/02

OWNER OR CONTRACTOR Horne Building Inc PHONE: Business 704-878-2224 Home

ADDRESS 254 Farmwood Dr, Statesville, NC 28625

LOCATION HWY 21 N. (L) Tabor, (L) Speaks Rd, lot on the left (Site address 143 Speaks Rd. - Olin, NC 28660

SUBDIVISION Padgett Farms BLOCK / SECTION LOT 7 LOT AREA 0.515 ACRES SITE CLASS. PS DESIGN FLOW 360 L.T.A.R. 0.30

Septic Tank: 1,000 Gallons; STB 1012 Date 2-16-04
Pump Tank: Gallons; PT Date
Pump Make: Model Serial No.
Nitrification Field: No Fields 1 Square Feet EQV to 1,200 Linear Feet 300
No Lines 4x75' Trench Width 36" Max Trench Bottom Depth 36"

[X] New System [ ] Repair System Type: I, II, (III) IV, V, VI
System Description: 25% Reduction Gravity
Repair System Description: 50% Reduction, Gravity/LP
Maintenance Agreement Required: [ ] Yes [X] No
Gravel Depth N/A [ ] Slab [X] Crawl Space [ ] Basement w/plumbing [ ] Basement wo/plumbing


[X] House/Mod. Home No. Bedrooms 3
[ ] Mobile Home No. Bathrooms 2
[ ] Business No. Employees
[ ] Other

Water Supply: [ ] Individual [X] Public [ ] Community


Comments/Conditions: (1) Install French drain 48" deep around system, then to daylight. (2) Keep system including tank 10' down slope, 15' side slope from French drain.

Comments/Conditions: (1) TOFF-TITE FILTER (2) INFILTRATOR CHAMBERS (3) French drain use #5 stone - installed accordingly

INITIAL SITE SKETCH

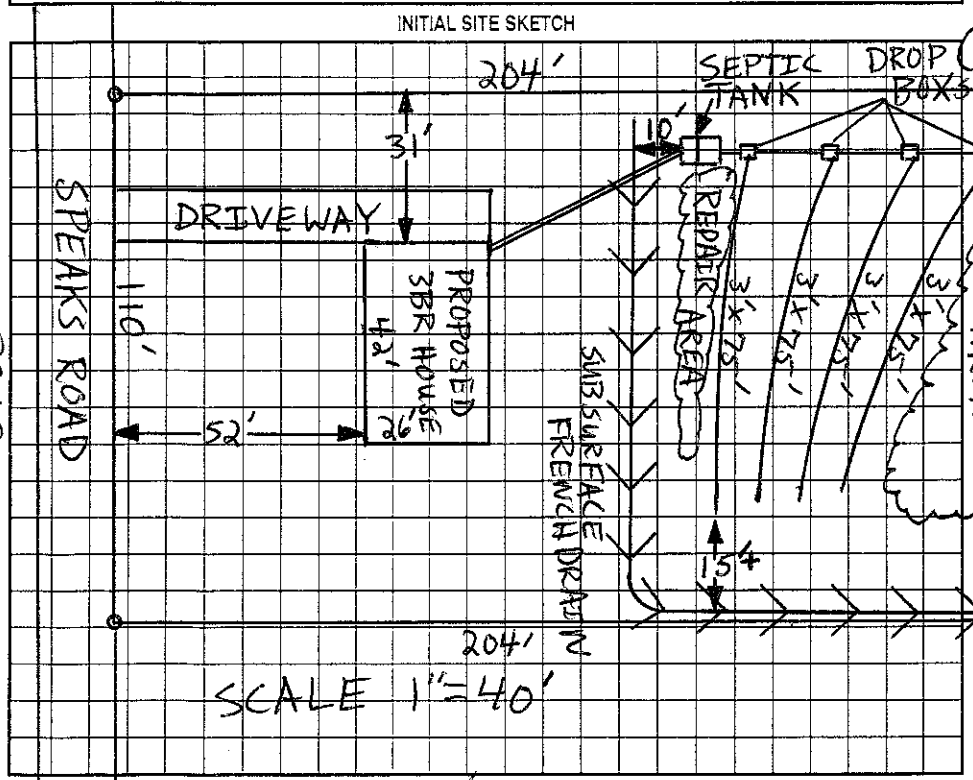

AS BUILT SKETCH

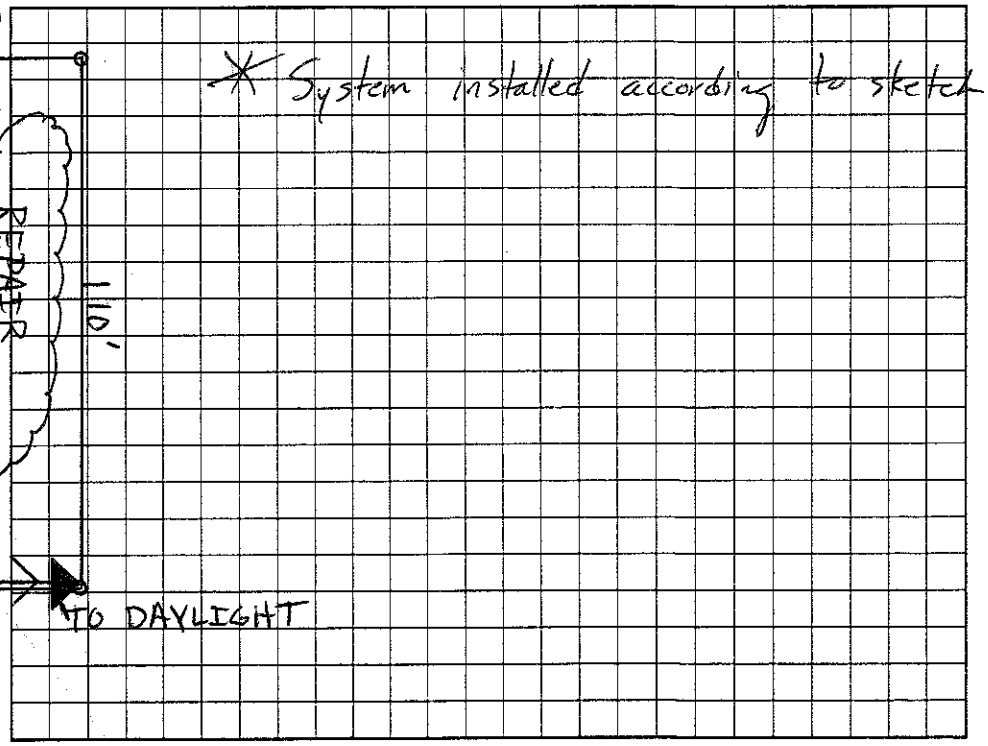

Permit can be suspended or revoked if any false information is supplied toward securing the permit/any unauthorized changes are made to the site/any unauthorized changes are made in the installation of the system. Improvement Permit with plat valid without expiration. Improvement Permit with site plan valid for sixty months. Authorization to Construct is valid for a period equal to that of Improvement Permit – not to exceed sixty months.

Signed: [signature] date 7-9-02 Installed by: C + S Grading

Improvement Permit by: Patrick Mitchell date 07/03/02 Operation Permit by: Christopher D. Shemwell, RS date 7/16/04

Authorization to Construct by: Patrick Mitchell date 07/03/02 Existing System Inspection by: date

HEALTH DEPT. COPY: WHITE OWNER COPY (FINAL): YELLOW OWNER COPY (INITIAL): PINK