IREDELL COUNTY HEALTH DEPARTMENT

Statesville Office (704) 878-5305 Mooresville Office (704) 660-3625 PERMIT # 217596

IMPROVEMENT PERMIT / AUTHORIZATION TO CONSTRUCT / OPERATION PERMIT / EXISTING SYSTEM

PIN # 4861322933

APPLICANT: David Shaver APPLICANT ADDRESS: 143 Speaks Rd Olin NC

SITE ADDRESS: 143 Speaks Rd Olin NC PHONE: 704-682-0167 ALT. PHONE: N/A

SITE DIRECTIONS: 77N to 901 T/R Tabor Rd T/R Speaks Rd Lot on left


SUBDIVISION: Padgett Farms SECTION: N/A LOT # 7 LOT AREA: 0.515ac DESIGN FLOW: Ex 360 L.T.A.R.: Ex

Septic Tank	Ex (gal)	STB	Date	☐ New System ☐ Repair ☐ Expansion System Type: I II ☒ III IV V VI	☑ Residence	No. Bedrooms	Ex 3	Water Supply
Pump Tank	(gal)	PT	Date	System Description: Existing	☐ Business	No. Persons	Ex 6	☐ Private
Pump Make	Model		Serial #	Repair System Description:	☐ Other	No. Employees		☑ Public
# Nitrification Fields	Ex # Lines	Ex	Linear Ft: Ex	Maintenance Agreement Required: ☐ YES ☒ NO	☐ Slab	☑ Crawl Space		☐ Community
Trench Width	Ex Max. Trench Bottom Depth	Ex	Gravel Depth N/A	☒ GRAVITY ☐ PRESSURE	☐ Basement w/plumbing		☐ Basement w/o plumbing	

Comments / Conditions: All building foundations must be 35 from any part of STS.

INITIAL SITE SKETCH

AS BUILT SKETCH

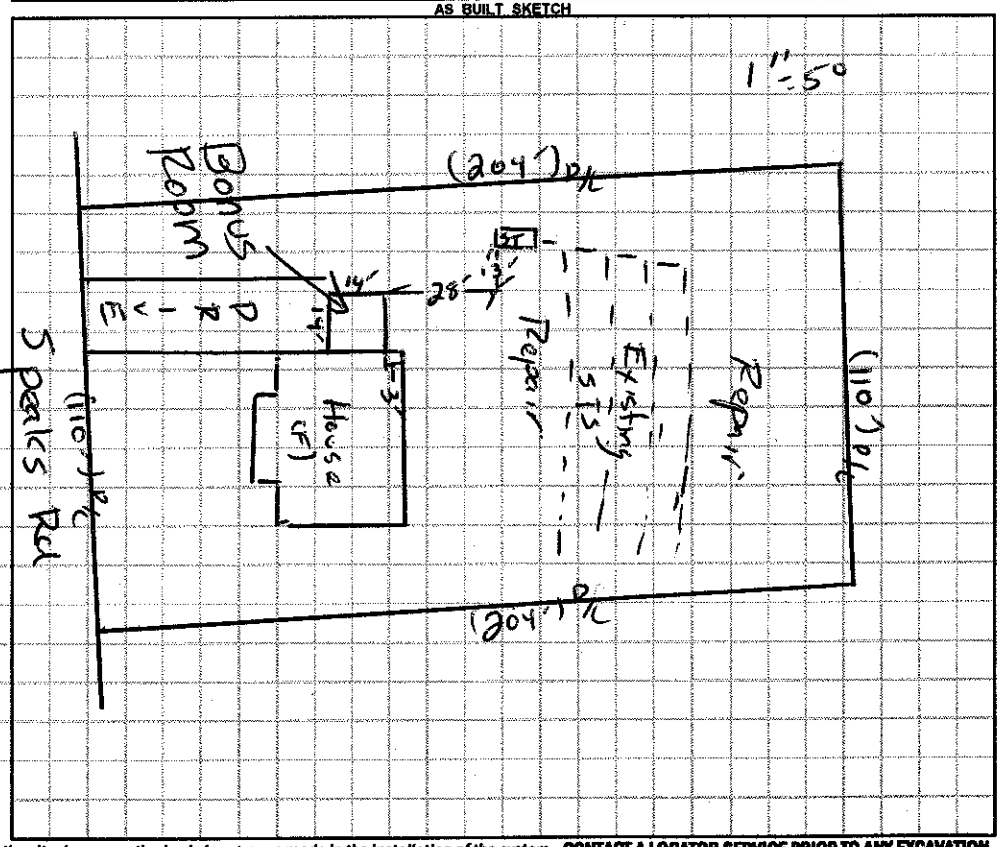

Permit can be suspended or revoked if any false information is supplied toward securing the permit / any unauthorized changes are made to the site / any unauthorized changes are made in the installation of the system. **CONTACT A LOCATOR SERVICE PRIOR TO ANY EXCAVATION**

☐ **IMPROVEMENT PERMIT** *with plat valid without expiration.* ☐ **IMPROVEMENT PERMIT** *with site plan valid for 60 mos.* ☐ **AUTHORIZATION TO CONSTRUCT** *valid for period equal to IMPROVEMENT PERMIT--not to exceed 60 mo.*

Owner / Applicant Signature: David Shaver Date: 4/29/16 Installed by:

IMPROVEMENT PERMIT by: Date: OPERATION PERMIT by: Date:

AUTHORIZATION TO CONSTRUCT by: Date: Existing System Inspected by: Date: 04/29/16

Health Dept. Copy - WHITE Applicant (Final Approval) - YELLOW Applicant (Conditional Approval) - PINK