CI

IREDELL COUNTY HEALTH DEPARTMENT

STATESVILLE 704-878-5305 MOORESVILLE 704-664-5281

IMPROVEMENT PERMIT / AUTHORIZATION TO CONSTRUCT / OPERATION PERMIT / EXISTING SYSTEM INSPECTION

PERMIT# 147975 PIN# 4861-32-3717 DATE 2-6-08

OWNER OR APPLICANT WESLEY COMMUNITY DEV. CORP PHONE: Business 704-924-8942 Home 704-902-5603

ADDRESS 1321-C DIXIE DRIVE, STATESVILLE NC 28677

LOCATION US 21 N, TL TABOR RD, TL SPEAKS RD, TL DEMILLE DR, TL PADGETT FARMS LN, 2ND LOT ON LEFT

SUBDIVISION PADGETT FARMS BLOCK / SECTION 3 LOT 27 LOT AREA 0.512 ACRE SITE CLASS. PS DESIGN FLOW 360 L.T.A.R. 0.25 GPD/FT²

Septic Tank: 1000 Gallons; STB 1007 Date 1-7-08
Pump Tank: _____ Gallons; PT _____ Date _____
Pump Make: _____ Model _____ Serial No. _____
Nitrification Field: No Fields 1 Square Feet 60 TO 1440 Linear Feet 360
No Lines FOUR Trench Width 36" Max Trench Bottom Depth 36"

☑ New System ☐ Repair ☐ Expansion System Type: I II III IV V VI
System Description: 25% REDUCTION GRAVITY
Repair System Description: 50% REDUCTION, LOW PRESSURE
Maintenance Agreement Required: ☐ Yes ☑ No

☑ House/Mod. Home No. Bedrooms 3
☐ Mobile Home No. Persons ____
☐ Business No. Employees ____
☐ Other ____


Water Supply: ☐ Individual ☑ Public ☐ Community

Gravel Depth N/A ☑ Gravity ☐ Pressure ☐ Slab ☑ Crawl Space ☐ Basement w/plumbing ☐ Basement wo/plumbing


Comments/Conditions: INSTALL 25% REDUCTION SYSTEM ON CONTOUR AS SHOWN

Comments/Conditions: DOWN FILL

INITIAL SITE SKETCH

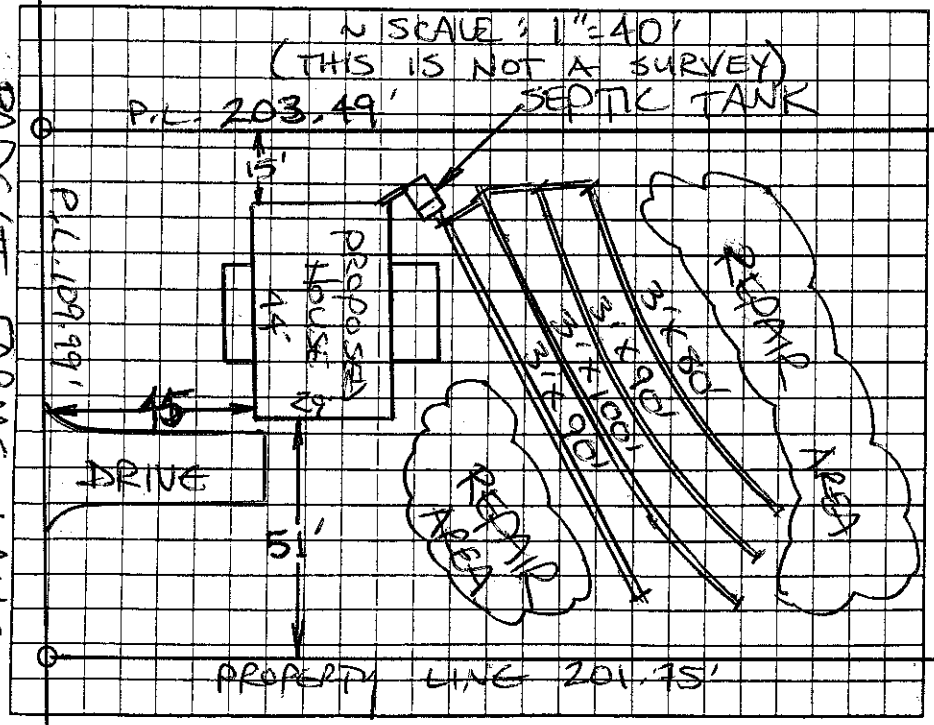

AS BUILT SKETCH

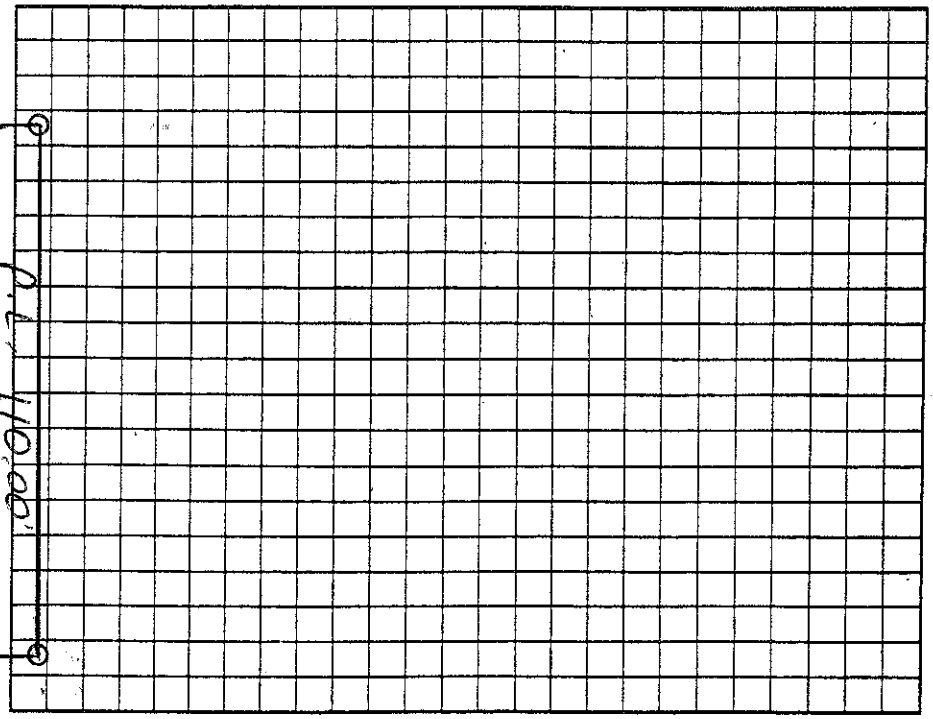

Permit can be suspended or revoked if any false information is supplied toward securing the permit/any unauthorized changes are made to the site/any unauthorized changes are made in the installation of the system. Improvement Permit with plat valid without expiration ☐ Improvement Permit with site plan valid for sixty months ☑ Authorization to Construct is valid for a period equal to that of Improvement Permit – not to exceed sixty months.

Signed: Wayne Wood date 2-7-08 Installed by: Tommy Cothren

Improvement Permit by: STEVE HEDRICK date 2-6-08 Operation Permit by: _____ date 3-19-08

Authorization to Construct by: STEVE HEDRICK date 2-6-08 Existing System Inspection by: _____ date _____

HEALTH DEPT. COPY: WHITE OWNER COPY (FINAL): YELLOW OWNER COPY (INITIAL): PINK