IREDELL COUNTY HEALTH DEPARTMENT

THIS PERMIT REPLACES PREVIOUS ISSUED 2-6-08

STATESVILLE 704-878-5305 MOORESVILLE 704-664-5281

IMPROVEMENT PERMIT / AUTHORIZATION TO CONSTRUCT / OPERATION PERMIT / EXISTING SYSTEM INSPECTION

PERMIT# 147976 PIN# 4861-32-3881 DATE 2-22-08

OWNER OR APPLICANT WESLEY COMMUNITY DEV. CORP PHONE: Business 704-924-8942 Home 704-902-5603

ADDRESS 1321-C DIXIE DRIVE, STATESVILLE, NC 28677

LOCATION US 21 N, TL TABOR RD, TL SPEARS RD, TL DEMILLE DR TL PADGETT FARMS LN TL BIG HORNE WAY, LOT ON LEFT

SUBDIVISION PADGETT FARMS BLOCK / SECTION 3 LOT 28 LOT AREA 0.505 ACRE SITE CLASS. PS DESIGN FLOW 360 L.T.A.R. 0.25 gpd/ft²

Septic Tank: 1000 Gallons: STB 1007 Date 2-2-08

Pump Tank: _____ Gallons: PT _____ Date _____

Pump Make: _____ Model _____ Serial No. _____

Nitrification Field: No Fields 1 Square Feet ~~1440~~ 1440 Linear Feet 360

No Lines FOUR Trench Width 36" Max Trench Bottom Depth 36"

☑ New System ☐ Repair ☐ Expansion System Type: I II III IV V VI

System Description: 25% REDUCTION, GRAVITY

Repair System Description: 50% REDUCTION, LOW-PRESSURE

Maintenance Agreement Required: ☐ Yes ☑ No

Gravel Depth N/A ☑ Gravity ☐ Pressure

☑ House/Mod. Home ☐ Mobile Home ☐ Business ☐ Other

No. Bedrooms 3 No. Persons ____ No. Employees ____


☐ Slab ☑ Crawl Space ☐ Basement w/plumbing ☐ Basement wo/plumbing

Water Supply: ☐ Individual ☑ Public ☐ Community


Comments/Conditions: INSTALL 25% REDUCTION SYSTEM ON CONTOUR AS SHOWN, NO DEEPER THAN 36"

Comments/Conditions: down hill

INITIAL SITE SKETCH ~ SCALE: 1" = 40'

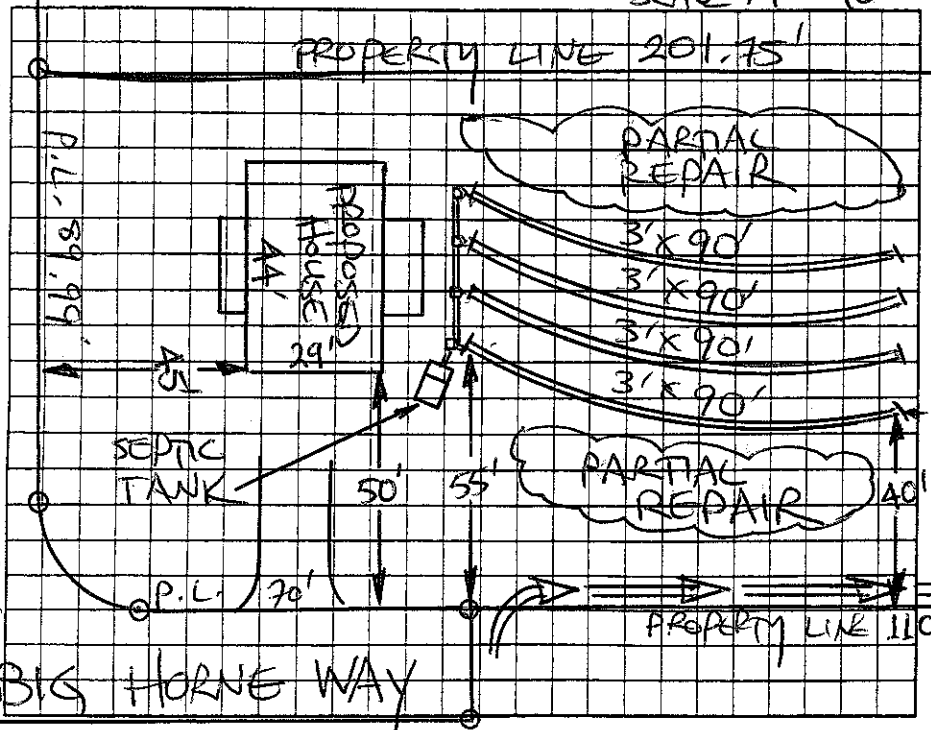

AS BUILT SKETCH

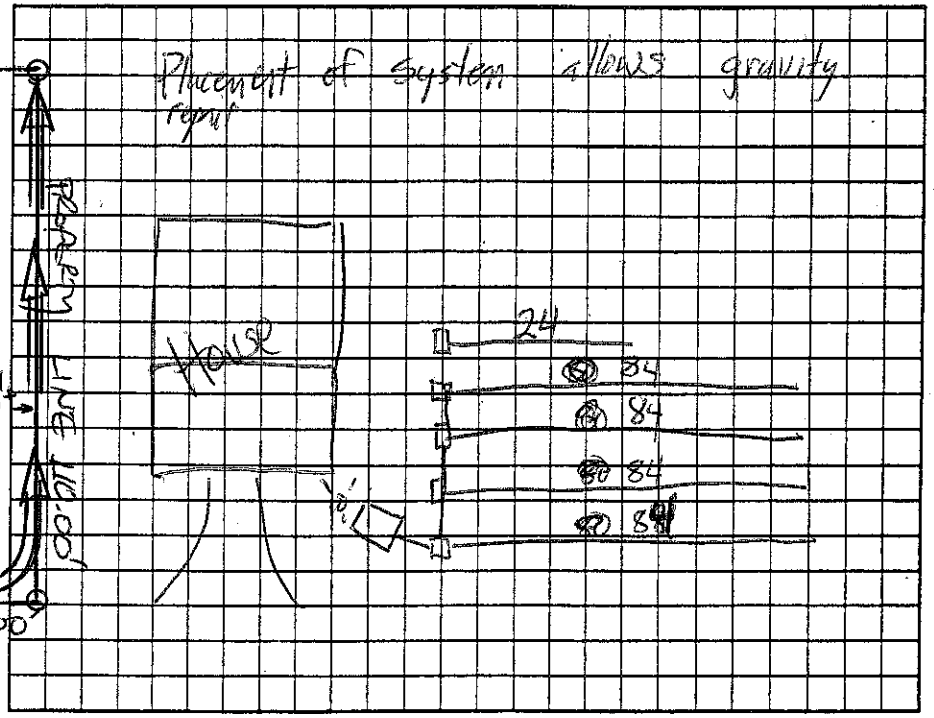

PADGETT FARMS LANE

Permit can be suspended or revoked if any false information is supplied toward securing the permit/any unauthorized changes are made to the site/any unauthorized changes are made in the installation of the system. Improvement Permit with plat valid without expiration ☐ Improvement Permit with site plan valid for sixty months ☑ Authorization to Construct is valid for a period equal to that of Improvement Permit – not to exceed sixty months.

Signed: Wayne Ward date 3-4-08 Installed by: Tommy Coffey

Improvement Permit by: STEVE HEDRICK date 2-22-08 Operation Permit by: _____ date 3-19-08

Authorization to Construct by: STEVE HEDRICK date 2-22-08 Existing System Inspection by: _____ date _____

HEALTH DEPT. COPY: WHITE OWNER COPY (FINAL): YELLOW OWNER COPY (INITIAL): PINK