IREDELL COUNTY HEALTH DEPARTMENT

STATESVILLE 704-878-5305 MOORESVILLE 704-664-5281

IMPROVEMENT PERMIT / AUTHORIZATION TO CONSTRUCT / OPERATION PERMIT / EXISTING SYSTEM INSPECTION

PERMIT# 101654 PIN# 4861-32-3947 DATE 8-14-01

OWNER OR CONTRACTOR HORNE BUILDING, INC PHONE: Business (704) 902-0399 Home (704) 878-2224

ADDRESS 254 FARMWOOD DRIVE STATESVILLE, NC 28625

LOCATION US 21 NORTH, TL TABOR ROAD, TL SPEAKS ROAD, 2ND LOT ON LEFT

SUBDIVISION PARGETT FARMS (OSBORNE SMITH) BLOCK / SECTION ____ LOT 6 LOT AREA 0.51 ACRES SITE CLASS PS DESIGN FLOW 360 L.T.A.R. 0.25 GAD/FT²

Septic Tank: 1000 Gallons: STB 1007 Date 9-14-01

Pump Tank: ____ Gallons, PT ____ Date ____

Pump Make: ____ Model ____ Serial No. ____

Nitrification Field: No Fields 1 Square Feet 60 @ 1440 Linear Feet 360'

No Lines FOUR Trench Width 36" Max Trench Bottom Depth 36" Gravel Depth N/A

☑ New System ☐ Repair System Type: I, II, III, IV, V, VI

System Description: 25% REDUCTION QUANTUM

Repair System Description: 50% REDUCTION LOW-PRO

Maintenance Agreement Required: ☐ Yes ☑ No

☑ House/Mod. Home No. Bedrooms 3

☐ Mobile Home No. Bathrooms 2

☐ Business No. Employees ____

☐ Other ____


☐ Slab ☑ Crawl Space ☐ Basement w/plumbing ☐ Basement wo/plumbing

Water Supply: ☐ Individual ☑ Public ☐ Community

Comments/Conditions: ① CONSTRUCT SUBSURFACE INTERCEPT DRAINAGE DITCH AT LOCATION SHOWN BEGINNING 48" DEEP UNTIL AROUND ENDS, THEN OUT TO DAYLIGHT ② INSTALL 25% REDUCTION SYSTEM USING 36 HDS SECTIONS OR 60 CHAMBERS UTILIZING CONTOUR WEDGES.

Comments/Conditions: ① SEPTIC TANK WITH MARKER INSTALLED USING "POLYLOK" FILTER ② SYSTEM INSTALLED UTILIZING 60 "INFILTRATOR" CHAMBERS W/ CONTOUR WEDGES.

INITIAL SITE SKETCH

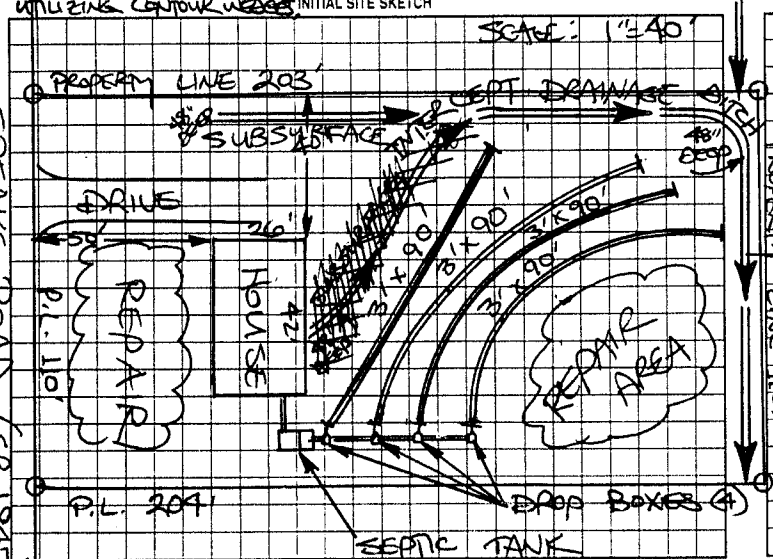

AS BUILT SKETCH

SYSTEM INSTALLED ACCORDING TO INITIAL SITE SKETCH

Permit can be suspended or revoked if any false information is supplied toward securing the permit/any unauthorized changes are made to the site/any unauthorized changes are made in the installation of the system. Improvement Permit with plat valid without expiration. Improvement Permit with site plan valid for sixty months. Authorization to Construct is valid for a period equal to that of Improvement Permit – not to exceed sixty months.

Signed: Jeffrey Horne date 8-14-01 Installed by: DALE FOX

Improvement Permit by: STEVE HEDRICK date 8-14-01 Operation Permit by: STEVE HEDRICK date 11-05-01

Authorization to Construct by: STEVE HEDRICK date 8-14-01 Existing System Inspection by: ____ date ____

HEALTH DEPT COPY WHITE OWNER COPY (FINAL) YELLOW OWNER COPY (INITIAL) PINK