IREDELL COUNTY HEALTH DEPARTMENT

STATESVILLE 704-878-5305 MOORESVILLE 704-664-5281

IMPROVEMENT PERMIT / AUTHORIZATION TO CONSTRUCT / OPERATION PERMIT / EXISTING SYSTEM INSPECTION

PERMIT# 130525 PIN# 4866132 ~~4483~~ 9750 DATE 8-24-05

OWNER OR CONTRACTOR Carolyn Home Builders PHONE: Business 704-878-2224 Home

ADDRESS 717 Waverly Place Statesville NC 28677

LOCATION Jamestown Mill Rd Jabo RD about 4 miles 1st field after Olin Valley

SUBDIVISION Prospect Acres BLOCK / SECTION II LOT 21 LOT AREA SITE CLASS P3 DESIGN FLOW 360 J.T.A.R. .3

Septic Tank: 1000 Gallons: STB 1012 Date 7-26-05

Pump Tank: Gallons: PT Date

Pump Make: Model Serial No.

Nitrification Field: No Fields Square Feet 1200 Linear Feet 300

No Lines 5 Trench Width 36" Max Trench Bottom Depth 36" Gravel Depth NA

☑ New System ☐ Repair System Type I, II, III, IV, V, VI

System Description: 25% Grav

Repair System Description: 25% - Pump

Maintenance Agreement Required: ☐ Yes ☐ No

☐ House/Mod. Home No. Bedrooms 3

☐ Mobile Home No. Bathrooms

☐ Business No. Employees


☐ Other

☐ Slab ☑ Crawl Space ☐ Basement w/plumbing ☐ Basement wo/plumbing

Water Supply: ☐ Individual ☑ Public ☐ Community

Comments:/Conditions: Install on contour. Maintain setbacks Use Effluent Splitter (1"=50')

INITIAL SITE SKETCH

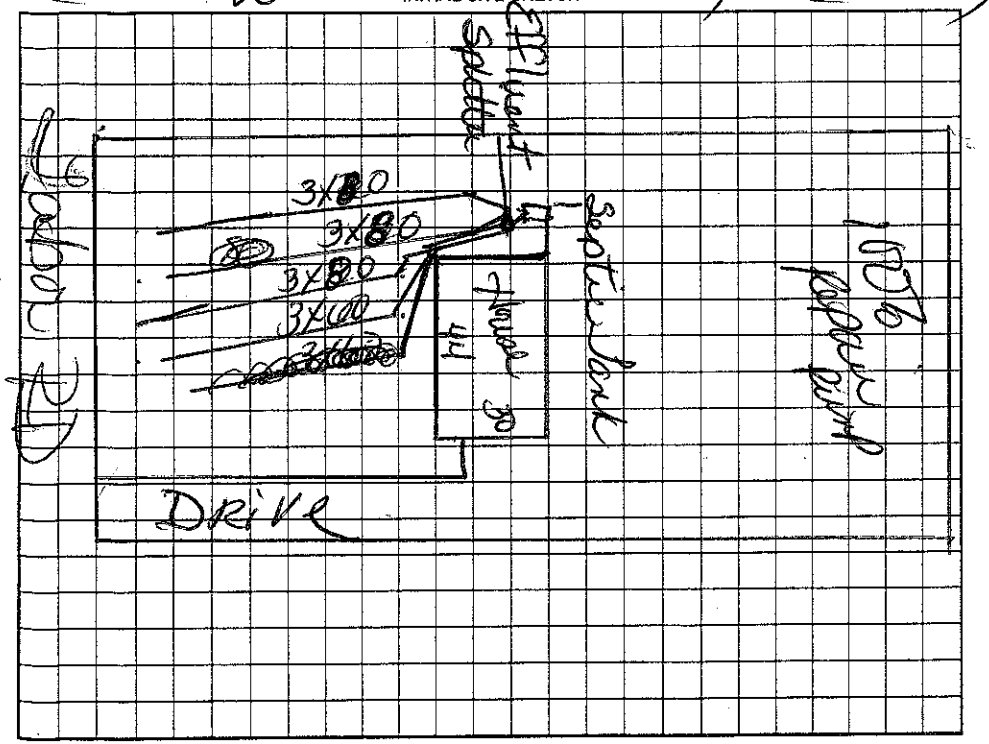

Comments:/Conditions: Yellow Sup Lots Septic Moved

AS BUILT SKETCH

House is closer than original permit — to Road

Drive is closer to house and septic than was supposed to be and was drawn

Permit can be suspended or revoked if any false information is supplied toward securing the permit/any unauthorized changes are made to the site/any unauthorized changes are made in the installation of the system. Improvement Permit with plat valid without expiration. Improvement Permit with site plan valid for sixty months. Authorization to Construct is valid for a period equal to that of Improvement Permit – not to exceed sixty months.

Signed: Carolyn P Horn date 8-25-05 Installed by: Jeremy Lough

Improvement Permit by: Kyle Cook date 8-23-05 Operation Permit by: Kyle Cook date 3-3-06

Authorization to Construct by: Kyle Cook date 8-23-05 Existing System Inspection by: date

HEALTH DEPT. COPY: WHITE OWNER COPY (FINAL): YELLOW OWNER COPY (INITIAL): PINK