IREDELL COUNTY HEALTH DEPARTMENT

STATESVILLE 704-878-5305 MOORESVILLE 704-664-5281

IMPROVEMENT PERMIT / AUTHORIZATION TO CONSTRUCT / OPERATION PERMIT / EXISTING SYSTEM INSPECTION

PERMIT# 101653 PIN# 4861 - 33 - 4032 DATE 8-14-01

OWNER OR CONTRACTOR HORNE BUILDING INC PHONE: Business (704) 902-0399 Home (704) 878-2224

ADDRESS 254 FARMWOOD DRIVE STATESVILLE, NC 28625

LOCATION US 21 NORTH, TL TABOR ROAD, TL SPEAKS ROAD, 2ND LOT ON LEFT

SUBDIVISION PADGETT FARMS BLOCK / SECTION _____ LOT 5 LOT AREA 0.51 ACRE SITE CLASS PS DESIGN FLOW 360 L.T.A.R. 0.25 GPD/FT2

Septic Tank: 1000 Gallons; STB 1007 Date 9-3-01

Pump Tank: _____ Gallons; PT _____ Date _____

Pump Make: _____ Model _____ Serial No. _____

Nitrification Field: No Fields 1 Square Feet BD. @ 1440 Linear Feet 360

No Lines FOUR Trench Width 36" Max Trench Bottom Depth 36" Gravel Depth N/A

☒ New System ☐ Repair System Type: I II III IV V VI

System Description: 25% REDUCTION GRAVITY

Repair System Description: 50% REDUCTION, PUMP

Maintenance Agreement Required: ☐ Yes ☒ No

☐ Slab ☐ Crawl Space ☐ Basement w/plumbing ☐ Basement wo/plumbing

☒ House/Mod. Home No. Bedrooms 3

☐ Mobile Home No. Bathrooms 2

☐ Business No. Employees _____


☐ Other _____

Water Supply: ☐ Individual ☒ Public ☐ Community

Comments/Conditions: CONSTRUCT SUBSURFACE INTERCEPT DRAINAGE DITCH AT LOCATION SHOWN BEGINNING 48" DEEP WITH AROUND ENDS THEN OUT TO DAYLIGHT ② INSTALL 25% REDUCTION SYSTEM USING 36 HDS SECTIONS OR 60 CHAMBERS UTILIZING CONTOUR WEDGES.

Comments/Conditions: SEPTIC TANK WITH MARKER INSTALLED USING "POLYLOK" FILTER

INITIAL SITE SKETCH

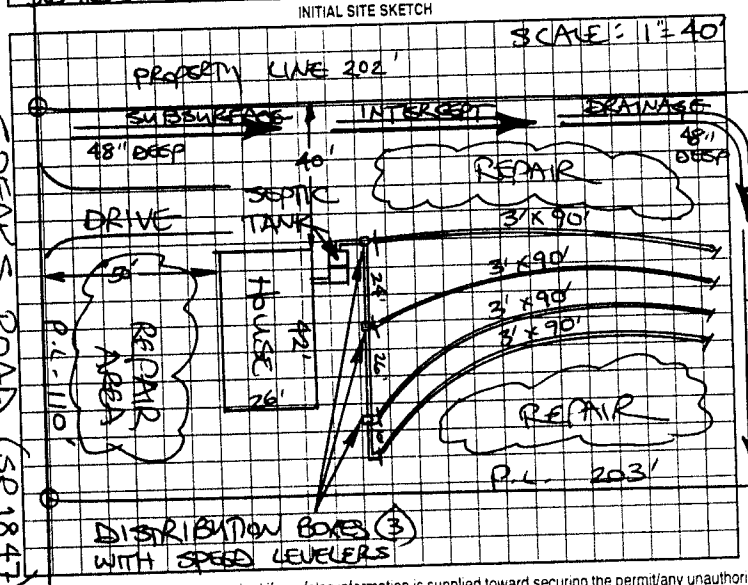

AS BUILT SKETCH

SYSTEM INSTALLED ACCORDING TO INITIAL SITE SKETCH

Permit can be suspended or revoked if any false information is supplied toward securing the permit/any unauthorized changes are made to the site/any unauthorized changes are made in the installation of the system. Improvement Permit with plat valid without expiration. Improvement Permit with site plan valid for sixty months. Authorization to Construct is valid for a period equal to that of Improvement Permit – not to exceed sixty months.

Signed: A/F Horne date 8-14-01

Improvement Permit by: STEVE HEDRICK date 8-14-01

Authorization to Construct by: STEVE HEDRICK date 8-14-01

Installed by: DALE FOX

Operation Permit by: STEVE HEDRICK date 11-02-01

Existing System Inspection by: _____ date _____

HEALTH DEPT. COPY: WHITE OWNER COPY (FINAL): YELLOW OWNER COPY (INITIAL): PINK