IREDELL COUNTY HEALTH DEPARTMENT

STATESVILLE 704-878-5305 (C1) MOORESVILLE 704-664-5281

IMPROVEMENT PERMIT / AUTHORIZATION TO CONSTRUCT / OPERATION PERMIT / EXISTING SYSTEM INSPECTION

PERMIT# 107108 PIN# 4861-33-5045 DATE 07/02/02

OWNER OR CONTRACTOR Horne Building Inc PHONE: Business 704-878-2224 Home

ADDRESS 254 Farmwood Dr. Statesville, NC 28625

LOCATION HWY 21 N., (L) Tabor Rd, (L) SPEAKS, Lot on left

SUBDIVISION Padgett Farms BLOCK / SECTION LOT 4 LOT AREA 0.507 Acres SITE CLASS. PS DESIGN FLOW 360 L.T.A.R. 0.30

Septic Tank: 1,000 Gallons; STB 1012 Date 6-11-02

Pump Tank: Gallons; PT Date

Pump Make: Model Serial No.

Nitrification Field: No Fields 1 Square Feet 1,200 Linear Feet 300

No Lines 3x100' Trench Width 36" Max Trench Bottom Depth 36"

(X) New System ( ) Repair System Type: I, II, (III), IV, V, VI

System Description: 25% Reduction Gravity

Repair System Description: 50% Reduc. Gravity/LP

Maintenance Agreement Required: ( ) Yes (X) No

Gravel Depth N/A

(X) House/Mod. Home No. Bedrooms 3

( ) Mobile Home No. Bathrooms 2

( ) Business No. Employees

( ) Other


( ) Slab (X) Crawl Space ( ) Basement w/plumbing ( ) Basement wo/plumbing

Water Supply: ( ) Individual (X) Public ( ) Community


Comments/Conditions: (1) Level Field terrace (2) Don't take too much soil off top, Just smooth surface (3) Make sure drainage around house is above house, NOT BELOW. (4) Call Prior to installation for tank location, (5) Stub out collection sewer high to tank.

Comments/Conditions: (1) SEPTIC TANK WITH MARKER INSTALLED (2) USING "TUFTITE" FILTER (3) SYSTEM INSTALLED AS SHOWN DUE TO DECK LOCATION

INITIAL SITE SKETCH

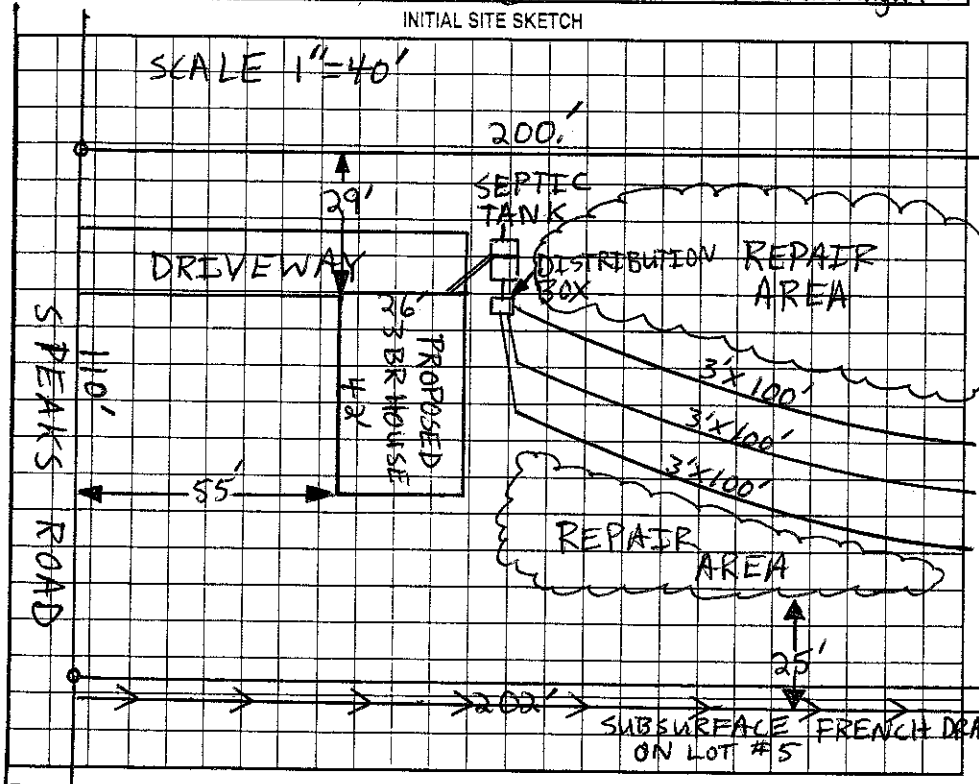

AS BUILT SKETCH

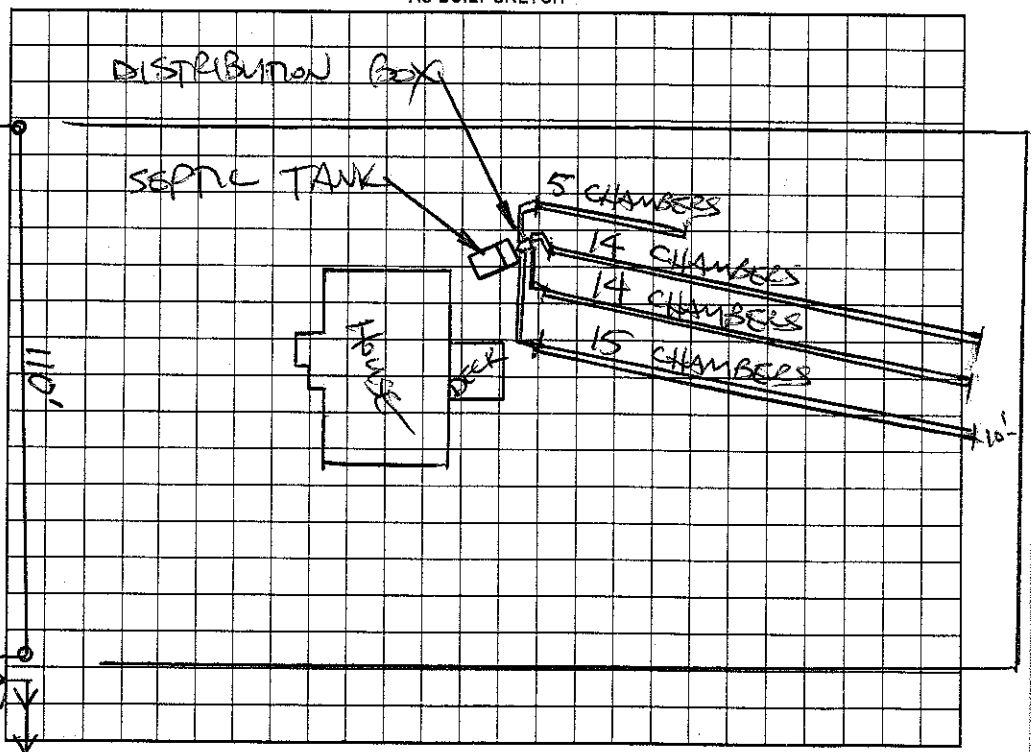

Permit can be suspended or revoked if any false information is supplied toward securing the permit/any unauthorized changes are made to the site/any unauthorized changes are made in the installation of the system. Improvement Permit with plat valid without expiration. Improvement Permit with site plan valid for sixty months. Authorization to Construct is valid for a period equal to that of Improvement Permit – not to exceed sixty months.

Signed: date 7-9-02 Installed by: TOMMY FRYE

Improvement Permit by: Patrick Mitchell date 07/02/02 Operation Permit by: STEVE HERRICK date 1-14-03

Authorization to Construct by: Patrick Mitchell date 07/02/02 Existing System Inspection by: date

HEALTH DEPT. COPY: WHITE OWNER COPY (FINAL): YELLOW OWNER COPY (INITIAL): PINK