IREDELL COUNTY HEALTH DEPARTMENT

STATESVILLE 704-878-5305 MOORESVILLE 704-664-5281

IMPROVEMENT PERMIT / AUTHORIZATION TO CONSTRUCT / OPERATION PERMIT / EXISTING SYSTEM INSPECTION

PERMIT# 101643 PIN# 4861-33-5776 DATE 8-22-01

OWNER OR CONTRACTOR JACK SHOEMAKER PHONE: Business Home (704) 546-3077

ADDRESS 167 POWELL BRIDGE ROAD, HARMONY, NC 28634

LOCATION US 21 N, TL TABOR ROAD, 3RD LOT ON LEFT, PAST SPEAKS ROAD

SUBDIVISION BLOCK / SECTION LOT LOT AREA 3.82 ACRES SITE CLASS PS DESIGN FLOW 360 L.T.A.R. 0.30 spd/ft²

Septic Tank: 1000 Gallons: STB 620 Date 7-6-01
Pump Tank: Gallons: PT Date
Pump Make: Model Serial No.
Nitrification Field: No Fields 1 Square Feet 1200 Linear Feet 400
No Lines FIVE Trench Width 36" Max Trench Bottom Depth 36" Gravel Depth 12"

☑ New System ☐ Repair System Type: I II III IV V VI
System Description: CONVENTIONAL GRAVITY
Repair System Description: CONV. GRAVITY
Maintenance Agreement Required: ☐ Yes ☑ No
☐ Slab ☑ Crawl Space ☐ Basement w/plumbing ☐ Basement wo/plumbing


☐ House/Mod. Home No. Bedrooms 3
☑ Mobile Home No. Bathrooms 2
☐ Business No. Employees
☐ Other

Water Supply: ☐ Individual ☑ Public ☐ Community


Comments/Conditions:

Comments/Conditions: SEPTIC TANK WITH RISERS INSTALLED USING "ZABEL" FILTER

INITIAL SITE SKETCH SCALE: 1" = 60'

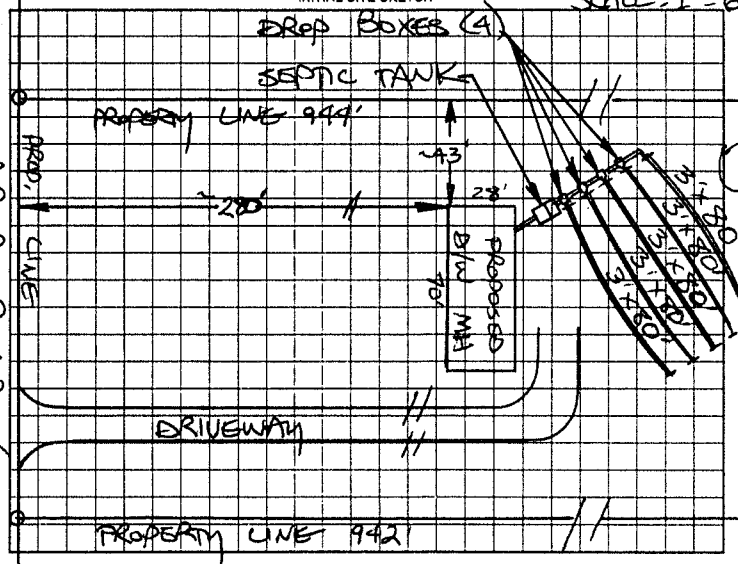

AS BUILT SKETCH

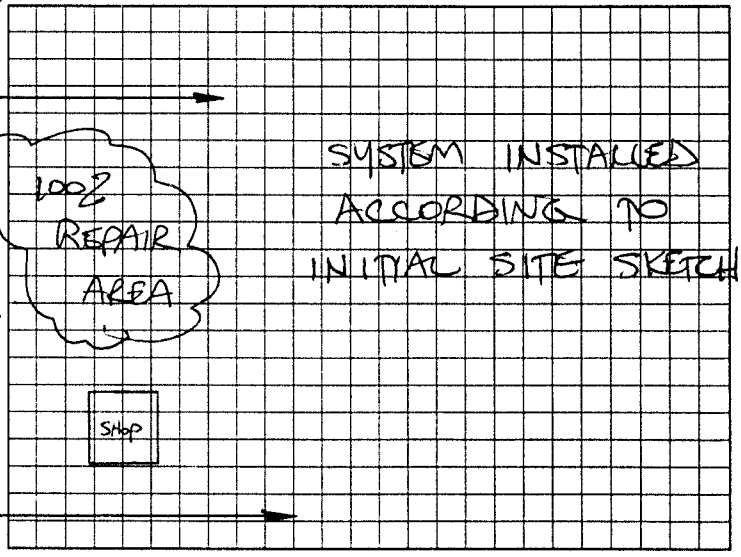

Permit can be suspended or revoked if any false information is supplied toward securing the permit/any unauthorized changes are made to the site/any unauthorized changes are made in the installation of the system. Improvement Permit with plat valid without expiration. Improvement Permit with site plan valid for sixty months. Authorization to Construct is valid for a period equal to that of Improvement Permit - not to exceed sixty months.

Signed: + Jack Shoemaker Jr. date 8-22-01 Installed by: SAMMY REAVIS

Improvement Permit by: STEVE HEDRICK date 8-22-01 Operation Permit by: STEVE HEDRICK date 9-10-01

Authorization to Construct by: STEVE HEDRICK date 8-22-01 Existing System Inspection by: date

HEALTH DEPT. COPY WHITE OWNER COPY (FINAL) YELLOW OWNER COPY (INITIAL) PINK