IREDELL COUNTY HEALTH DEPARTMENT

STATESVILLE 704-878-5305 MOORESVILLE 704-664-5281

IMPROVEMENT PERMIT / AUTHORIZATION TO CONSTRUCT / OPERATION PERMIT / EXISTING SYSTEM INSPECTION

PERMIT# 087019 PIN# 4861 33 5569 DATE 1-19-00

OWNER OR CONTRACTOR SHERRI BAGGARLY PHONE: Business Home 539-4458

ADDRESS 1035 W. MEMORIAL HWY., HARMONY, NC 28634

LOCATION US 21 NORTH, TL TABOR ROAD, 2ND LOT ON LEFT PAST SPEAKS ROAD

SUBDIVISION BLOCK / SECTION LOT LOT AREA 3.83 ACRES SITE CLASS PS DESIGN FLOW 480 L.T.A.R. 0.30 GPD/FT²

Septic Tank: 1000 Gallons; STB 620 Date 2-9-2000 ☒ New System ☐ Repair System Type: I, II, III, IV, V, VI

Pump Tank: Gallons; PT Date

Pump Make: Model Serial No

Nitrification Field: No Fields 1 Square Feet 1600 Linear Feet 533

No Lines SIX Trench Width 36" Max Trench Bottom Depth 36" Gravel Depth 12"

System Description: CONVENTIONAL GRAVITY

Repair System Description: 25% REDUCTION GRAVITY

Maintenance Agreement Required: ☐ Yes ☒ No

☐ House/Mod. Home ☒ Mobile Home ☐ Business ☐ Other FUTURE 4 BR HOUSE

No. Bedrooms 3 No. Bathrooms 2.5 No. Employees


☐ Slab ☒ Crawl Space ☐ Basement w/plumbing ☐ Basement wo/plumbing

Water Supply: ☐ Individual ☒ Public ☐ Community

Comments/Conditions: S/W MH TO BE REMOVED UPON OCCUPANCY OF FUTURE HOUSE ② USE ONE FLOW DIVIDER TEE TO ACHIEVE EQUAL DISTRIBUTION INTO TWO SERIES OF DROP BOXES.

Comments/Conditions: SEPTIC TANK W/ RISERS INSTALLED USING "TUFTITE" FILTER

INITIAL SITE SKETCH SCALE: 1" = 50'

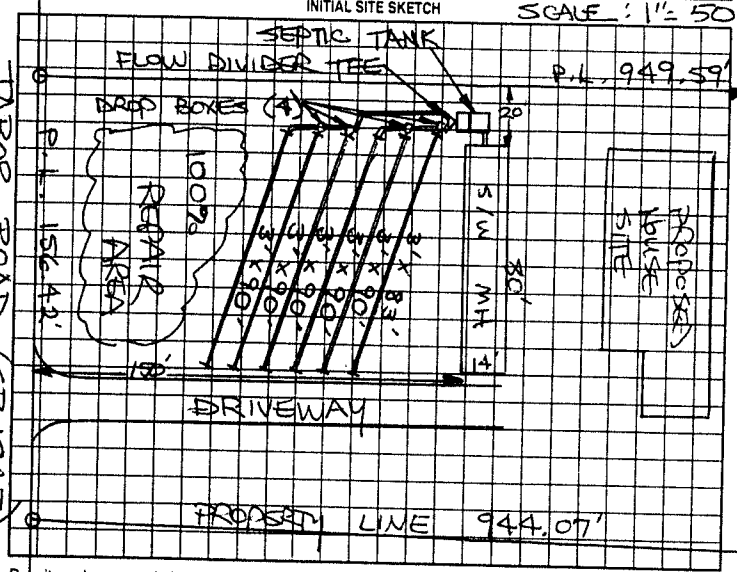

TABOR ROAD (SR 1845)

AS BUILT SKETCH

SYSTEM INSTALLED ACCORDING TO INITIAL SITE SKETCH

Permit can be suspended or revoked if any false information is supplied toward securing the permit/any unauthorized changes are made to the site/any unauthorized changes are made in the installation of the system. Improvement Permit with plat valid without expiration. Improvement Permit with site plan valid for sixty months. Authorization to Construct is valid for a period equal to that of Improvement Permit – not to exceed sixty months.

Signed: date 1-19-2000 Installed by: SAMMY REALS

Improvement Permit by: STEVE HERRICK date 1-19-00 Operation Permit by: STEVE HERRICK date 5-10-00

Authorization to Construct by: STEVE HERRICK date 1-19-00 Existing System Inspection by: date

HEALTH DEPT. COPY: WHITE OWNER COPY (FINAL): YELLOW OWNER COPY (INITIAL): PINK