IREDELL COUNTY HEALTH DEPARTMENT

STATESVILLE 704-878-5305 MOORESVILLE 704-664-5281

IMPROVEMENT PERMIT / AUTHORIZATION TO CONSTRUCT / OPERATION PERMIT / EXISTING SYSTEM INSPECTION

PERMIT# 088516 PIN# 4861 33 8420 DATE 4-19-2000

OWNER OR CONTRACTOR PATRICIA Mc INTOSH PHONE: Business Home 878-9061

ADDRESS P.O. Box 5084, STATESVILLE, NC 28687

LOCATION US 21 N, TL TABOR ROAD, TL SPEAKS ROAD, 2ND LOT ON RIGHT

SUBDIVISION PADGETT FARMS BLOCK / SECTION LOT 2 LOT AREA 0.534 ACRE SITE CLASS PS DESIGN FLOW 360 L.T.A.R. 0.30 <GPD/FT2>

Septic Tank: 1000 Gallons; STB 319 Date 1-7-00

Pump Tank: Gallons, PT Date

Pump Make: Model Serial No.

Nitrification Field: No Fields 1 Square Feet EQUIP/200 Linear Feet 300'

No Lines FIVE Trench Width 36" Max Trench Bottom Depth 36" ~~Rock~~ Depth SAND 6"

☑ New System ☐ Repair System Type: I, II, (III), IV, V, VI

System Description: 25% REDUCTION GRAVITY

Repair System Description: 25% REDUCTION, Pump

Maintenance Agreement Required: ☐ Yes ☑ No

☑ House/Mod. Home No. Bedrooms 3

☐ Mobile Home No. Bathrooms 2

☐ Business No. Employees

☐ Other

☐ Slab ☑ Crawl Space ☐ Basement w/plumbing ☐ Basement wo/plumbing


Water Supply: ☐ Individual ☑ Public ☐ Community

Comments/Conditions: INSTALL 25% REDUCTION SYSTEM USING FIFTY (50) CHAMBERS OR THIRTY (30) HDS SECTIONS.

SCALE: 1" = 40'

Comments/Conditions: SEPTIC TANK W/ MARKER INSTALLED USING "TYFITE" FILTER

INITIAL SITE SKETCH

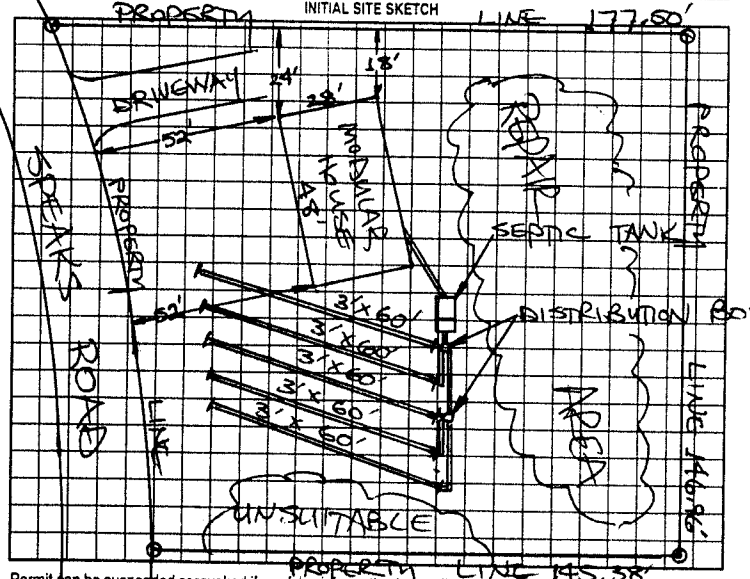

AS BUILT SKETCH

SYSTEM INSTALLED ACCORDING TO INITIAL SITE SKETCH

Permit can be suspended or revoked if any false information is supplied toward securing the permit/any unauthorized changes are made to the site/any unauthorized changes are made in the installation of the system. Improvement Permit with plat valid without expiration. Improvement Permit with site plan valid for sixty months. Authorization to Construct is valid for a period equal to that of Improvement Permit – not to exceed sixty months.

Signed: Patricia J. McIntosh date 4-24-00 Installed by: DAVID UMBARGER

Improvement Permit by: STEVE HEDRICK date 4-19-00 Operation Permit by: STEVE HEDRICK date 8-7-00

Authorization to Construct by: STEVE HEDRICK date 4-19-00 Existing System Inspection by: date

HEALTH DEPT. COPY: WHITE OWNER COPY (FINAL): YELLOW OWNER COPY (INITIAL): PINK