IREDELL COUNTY HEALTH DEPARTMENT

STATESVILLE 704-878-5305 MOORESVILLE 704-664-5281

IMPROVEMENT PERMIT / AUTHORIZATION TO CONSTRUCT / OPERATION PERMIT / EXISTING SYSTEM INSPECTION

PERMIT# 83827 PIN# 4861323731 DATE 9-30-99

OWNER OR CONTRACTOR James A McMillan PHONE: Business _____ Home 876-0372

ADDRESS 700 Whites Farm Rd

LOCATION 901 IR Tabor Rd before Speaks Rd on Rt.

SUBDIVISION Padgett Fm BLOCK / SECTION 1 LOT 1 LOT AREA .53 acres SITE CLASS PS DESIGN FLOW 360 L.T.A.R. .3

Septic Tank: 1000 Gallons; STB 1012 Date 10-3-99
Pump Tank: _____ Gallons; PT _____ Date _____
Pump Make: _____ Model _____ Serial No. _____
Nitrification Field: No Fields 1 Square Feet 1200 Linear Feet 400
No Lines 4 Trench Width 36" Max Trench Bottom Depth 36" Gravel Depth 12"


☑ New System ☐ Repair System Type: I, II, III, IV, V, VI
System Description: Conv. Gravity
Repair System Description: Pump To 25% Redu.
Maintenance Agreement Required: ☐ Yes ☑ No
☐ Slab ☑ Crawl Space ☐ Basement w/plumbing ☐ Basement wo/plumbing

☑ House/Mod. Home No. Bedrooms 3
☐ Mobile Home No. Bathrooms 2
☐ Business No. Employees _____
☐ Other _____

Water Supply: ☐ Individual ☑ Public ☐ Community

Comments/Conditions: Speaks Rd

INITIAL SITE SKETCH

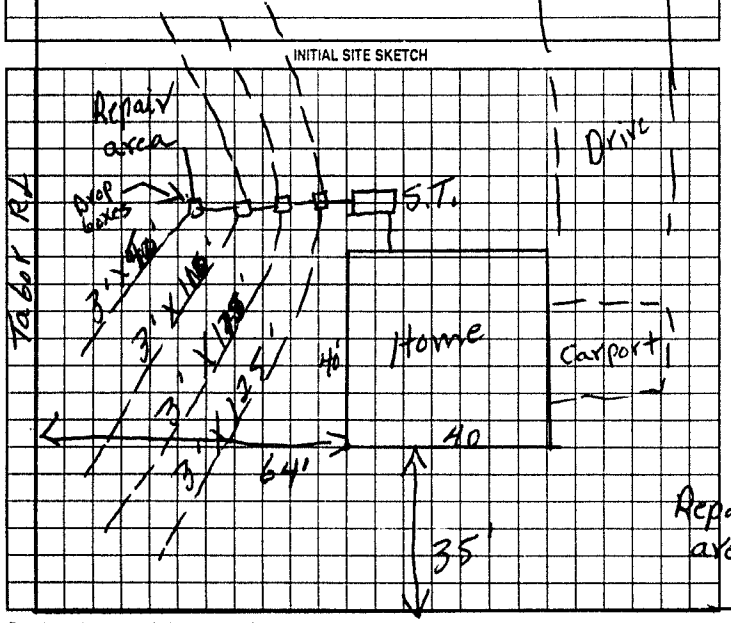

Comments/Conditions:

AS BUILT SKETCH

Same as initial Sketch Except lengths of lines

Permit can be suspended or revoked if any false information is supplied toward securing the permit/any unauthorized changes are made to the site/any unauthorized changes are made in the installation of the system. Improvement Permit with plat valid without expiration. Improvement Permit with site plan valid for sixty months. Authorization to Construct is valid for a period equal to that of Improvement Permit – not to exceed sixty months.

Signed: James A McMillan date _____ Installed by: Tommy Frye

Improvement Permit by: P.C. Moore date 9-30-99 Operation Permit by: P.C. Moore date 1-07-00

Authorization to Construct by: P.C. Moore date 9-30-99 Existing System Inspection by: _____ date _____

HEALTH DEPT. COPY: WHITE OWNER COPY (FINAL): YELLOW OWNER COPY (INITIAL): PINK