IREDELL COUNTY HEALTH DEPARTMENT

STATESVILLE 704-878-5305 MOORESVILLE 704-664-5281

IMPROVEMENT PERMIT / AUTHORIZATION TO CONSTRUCT / OPERATION PERMIT / EXISTING SYSTEM INSPECTION

PERMIT# Repair PIN#

OWNER OR CONTRACTOR Arthur Wilson DATE 5/4/98

ADDRESS PO Box Arthur OMI LANE Olin, NC 28660 PHONE: Business Home 546-5483

LOCATION 21N, Lt on Tabor, Lt on OMI Lane, At End

SUBDIVISION BLOCK / SECTION LOT LOT AREA SITE CLASS. DESIGN FLOW L.T.A.R.

Septic Tank: 1000 Gallons; STB 525 Date 5-11-98

Pump Tank: Gallons; PT Date

Pump Make: Model Serial No.

Nitrification Field: No Fields 1 Square Feet 900 Linear Feet 300

No Lines 3 Trench Width 36 Max Trench Bottom Depth 30 Gravel Depth 18"

☐ New System ☑ Repair System Type: I II III IV V VI

System Description: Conv. Gravity

Repair System Description:

Maintenance Agreement Required: ☐ Yes ☑ No

☐ House/Mod. Home No. Bedrooms 3

☑ Mobile Home No. Bathrooms

☐ Business No. Employees

☐ Other


☐ Slab ☐ Crawl Space ☐ Basement w/plumbing ☐ Basement wo/plumbing

Water Supply: ☑ Individual ☐ Public ☐ Community


Comments:/Conditions: Abandon ents system and plumb all wastewater into new system. 3 100' Lines w/ 18" Stone. New 1000 Gallon Tank

Comments:/Conditions: Divert Roof Street Water Off Septic System Do Not Drive, Park on Septic System

INITIAL SITE SKETCH

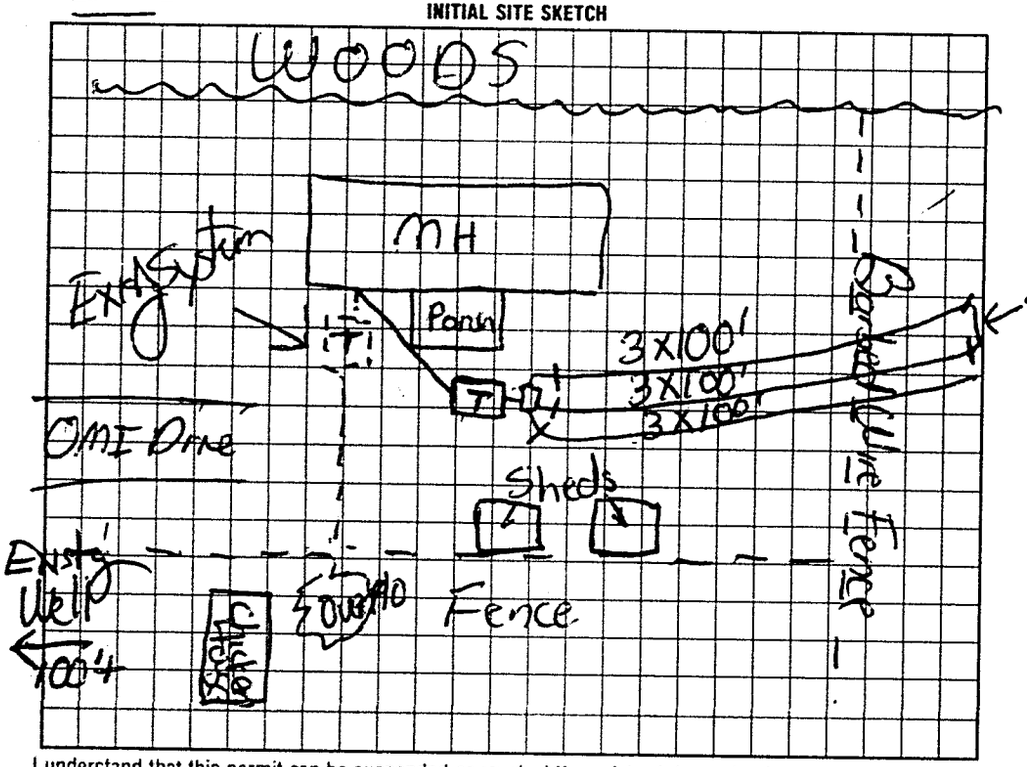

AS BUILT SKETCH

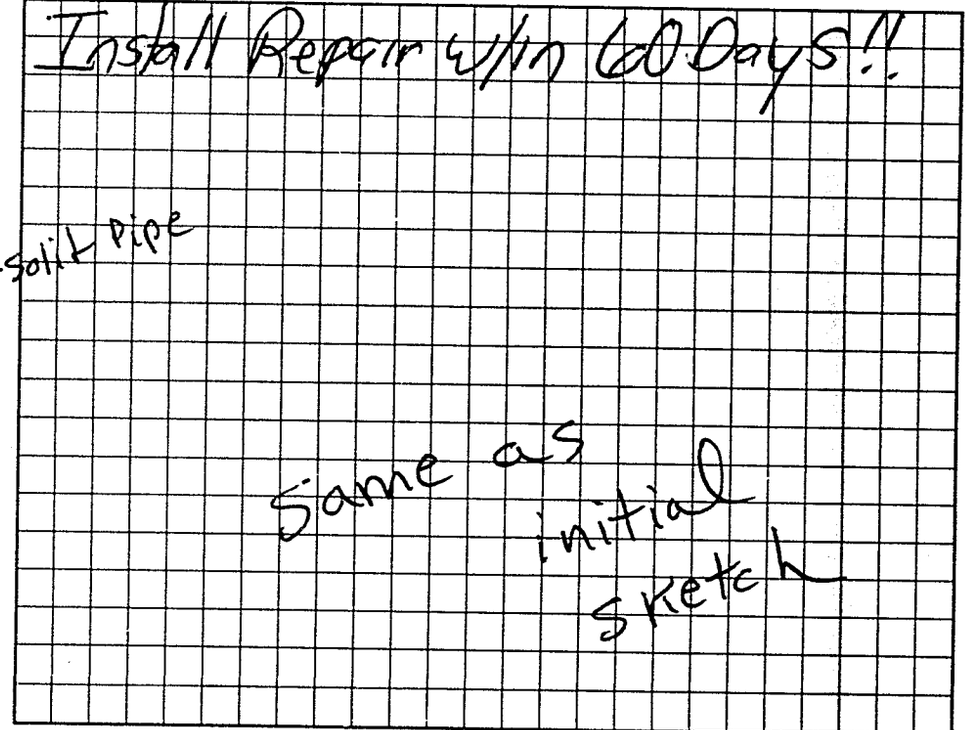

I understand that this permit can be suspended or revoked if any false information is supplied toward securing the permit/any unauthorized changes are made to the site/any unauthorized changes are made in the installation of the system. Improvement Permit with plat valid without expiration. Improvement Permit with site plan valid for sixty months. Authorization to Construct is valid for a period equal to that of Improvement Permit – not to exceed sixty months.

Signed: Jessie Wilson date 5/4/98 Installed by: K+K Grading

Improvement Permit by: Kelly Sheets date 5/4/98 Operation Permit by: R. C. Woods date 7-13-98

Authorization to Construct by: date 5/4/98 Existing System Inspection by: date

HEALTH DEPT COPY: WHITE INSPECTION COPY (FINAL): GREEN OWNER COPY (FINAL): YELLOW INSPECTION COPY (INITIAL): PINK OWNER COPY (INITIAL): GOLD

8 7 8 0 0